



1 2 3 4 5 6

A

B

C

D

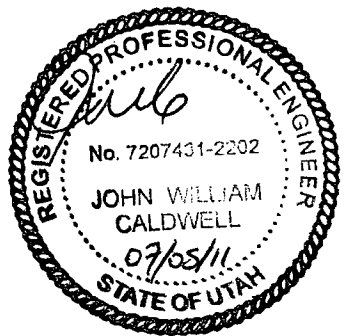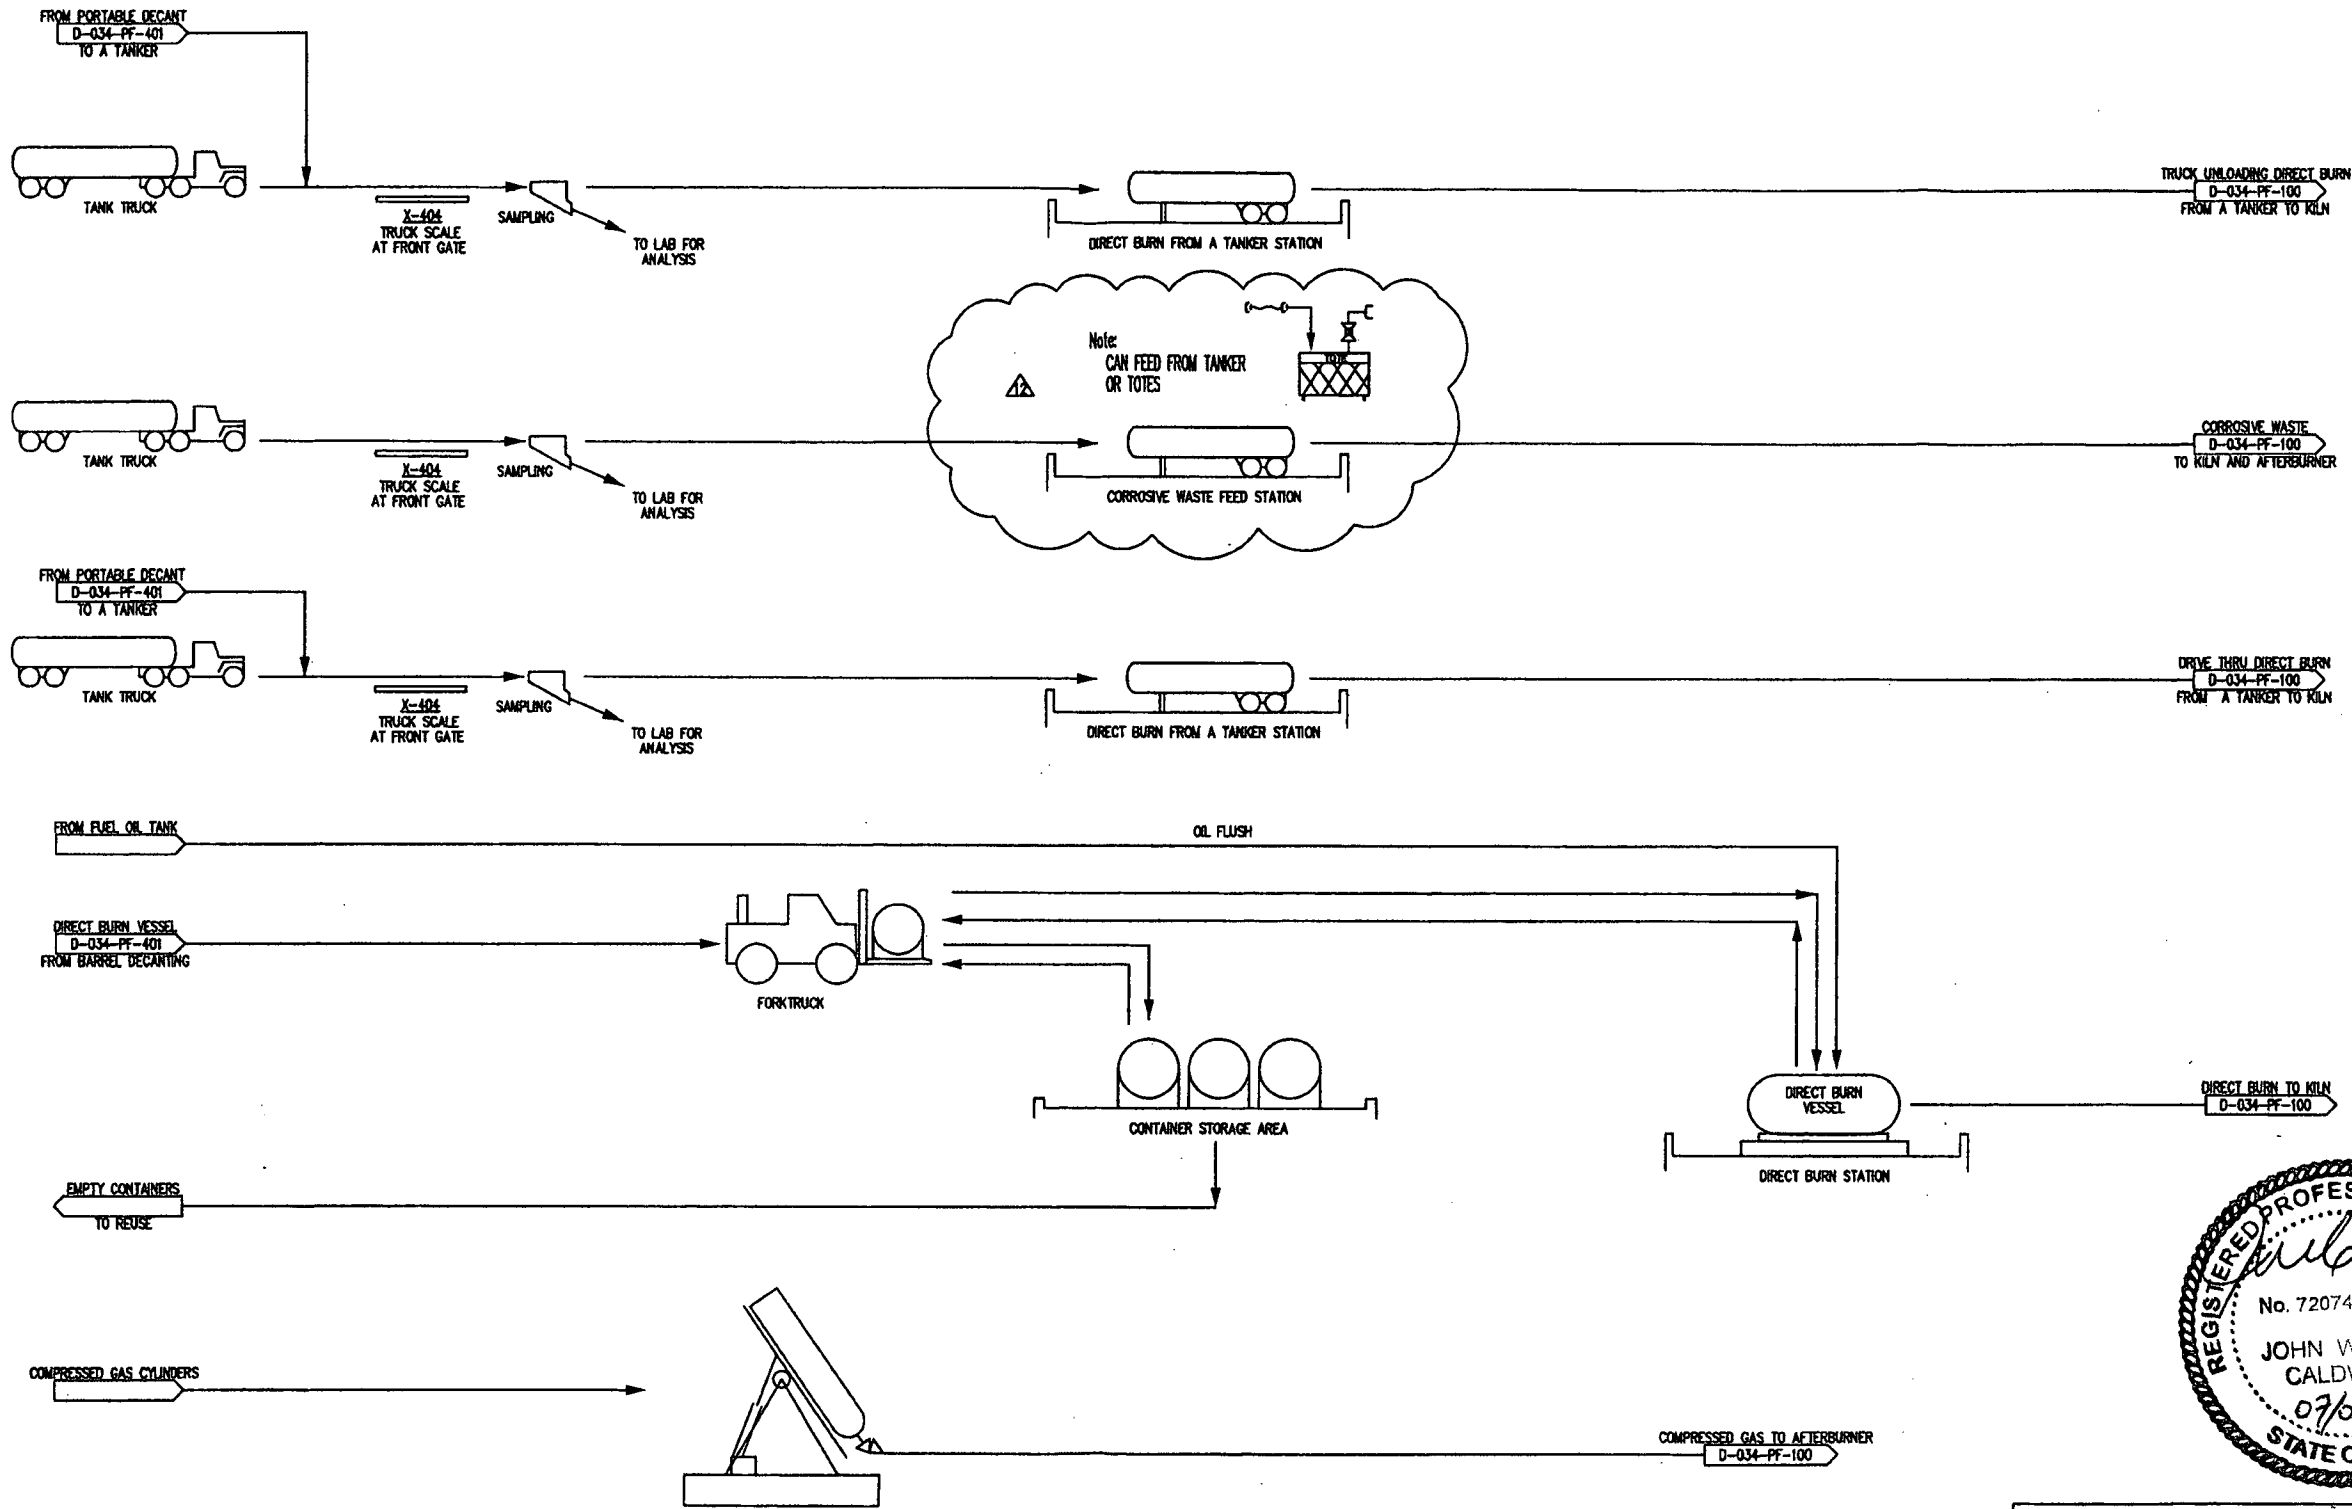

REVISIONS										REVISIONS										REFERENCE DRAWINGS	
NO	DESCRIPTION	DATE	BY	CHK	ELEC	MECH	STR	PROJ MGR	NO	DESCRIPTION	DATE	BY	CHK	ELEC	MECH	STR	PROJ MGR	DRAWING NO	TITLE		
1	AS BUILT	02-07-91	DVD	TB				JV	1	ADDED TRUCK UNLOADING DIRECT BURN	03-27-02	GVC									
2	AS BUILT	06-27-91	DCP					CHW	2	ADDED TRUCKS LOADED BY PORTABLE	04-16-03	KL									
3	AS BUILT	10-15-91	DCP					CHW	3	DECANT GENERAL REVISION											
4	AS BUILT	12-07-93	DCP				JV		4	ADDED CYLINDERS CHANGED TITLE	06-08-03	KL									
5	ADDED DIRECT BURN FROM A TANKER	08-09-00	GVC						5	ADDED CORROSIVE WASTE	02-22-08	KL									
6	AS BUILT	9-26-00	GVC						6	ADDED CORROSIVE WASTE TO ABC	06-16-08	KL									
7	ADDED DIRECT BURN FROM A TANKER	08-09-00	GVC						7	ADDED TOTES	04-11-11	LCC									
8	ADDED LINE TO D-034-PF-402	3-15-01	GVC																		

APPROVALS			CURRENT DRAWING STATUS	
BY	DATE		BY	DATE
DCP	2-07-93	PRELIMINARY OR PLANNING		
		APPROVED FOR FINAL DESIGN		
		APPROVED FOR QUOTE/PURCH		
		APPROVED FOR CONSTRUCTION		
		AS-BUILT	CHW	12-08-93

**CleanHarbors**  
ARAGORNITE LLC

UTAH ENVIRONMENTAL SERVICE CENTER  
INCINERATION PLANT FOR INDUSTRIAL WASTES  
DIRECT BURN & CYLINDER MATERIAL HANDLING FLOWSHEET

FOR TOOELE SITE

SCALE NONE JOB NO ENG. DWG NO CAD DESK FILE MA061L  
D-034-PF-302 12

REGISTERED PROFESSIONAL ENGINEER  
DATE: