


NO	DESCRIPTION
211-1	LOW LOW O <sub>2</sub> IN AFTERBURNER CHAMBER SHUTDOWN WESP
211-3	WESP MALFUNCTION SHUTS DOWN FEED (MASTER INTERLOCK)

REVISIONS										
NO	DESCRIPTION	DATE	BY	CHK	ELEC	MECH	STR	PROJ MGR	DRAWING NO	TITLE
1	ISSUED FOR CONSTRUCTION	7-7-89	MU	IRB				JV		
2	AS BUILT	06-26-91	DCP	JV						
3	AS BUILT	10-14-91	DCP					CHW		
4	AS BUILT UPDATE	12-06-93	DCP				JV			
5	AS BUILT	03-13-97	CRM							

REFERENCE DRAWINGS		APPROVALS		CURRENT DRAWING STATUS	
DRAWING NO	TITLE	BY	DATE	BY	DATE
		CRM	03-13-97		

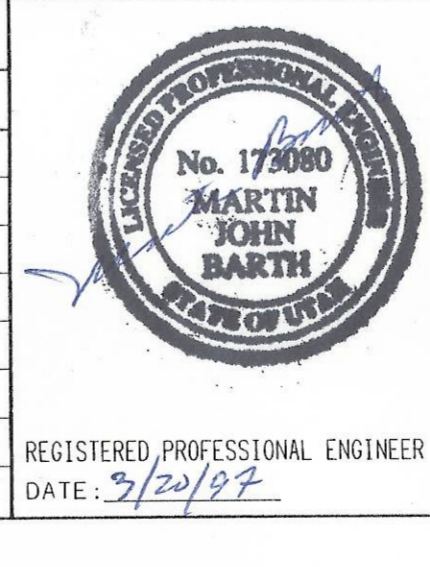

CONSULTING ENGINEER

# APTUS

11600 NORTH APTUS ROAD, ARAGONITE, UT. 84029 (801) 531-4200

TITLE  
**UTAH ENVIRONMENTAL SERVICE CENTER  
 INCINERATION PLANT FOR INDUSTRIAL WASTES  
 P&ID WET ELECTROSTATIC PRECIPITATOR**

FOR TOOELE SITE  
 SCALE NONE  
 JOB NO  
 ENG. DWG NO

CAD DISK FILE  
 IHW531

APTUS DWG NO  
**D-034-PI-211**

REV  
**4**