
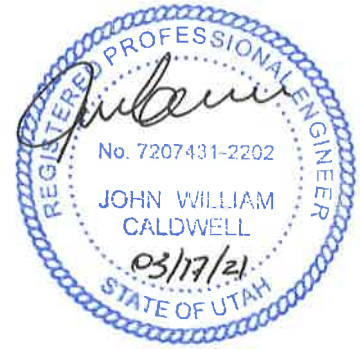


A
B
C
D

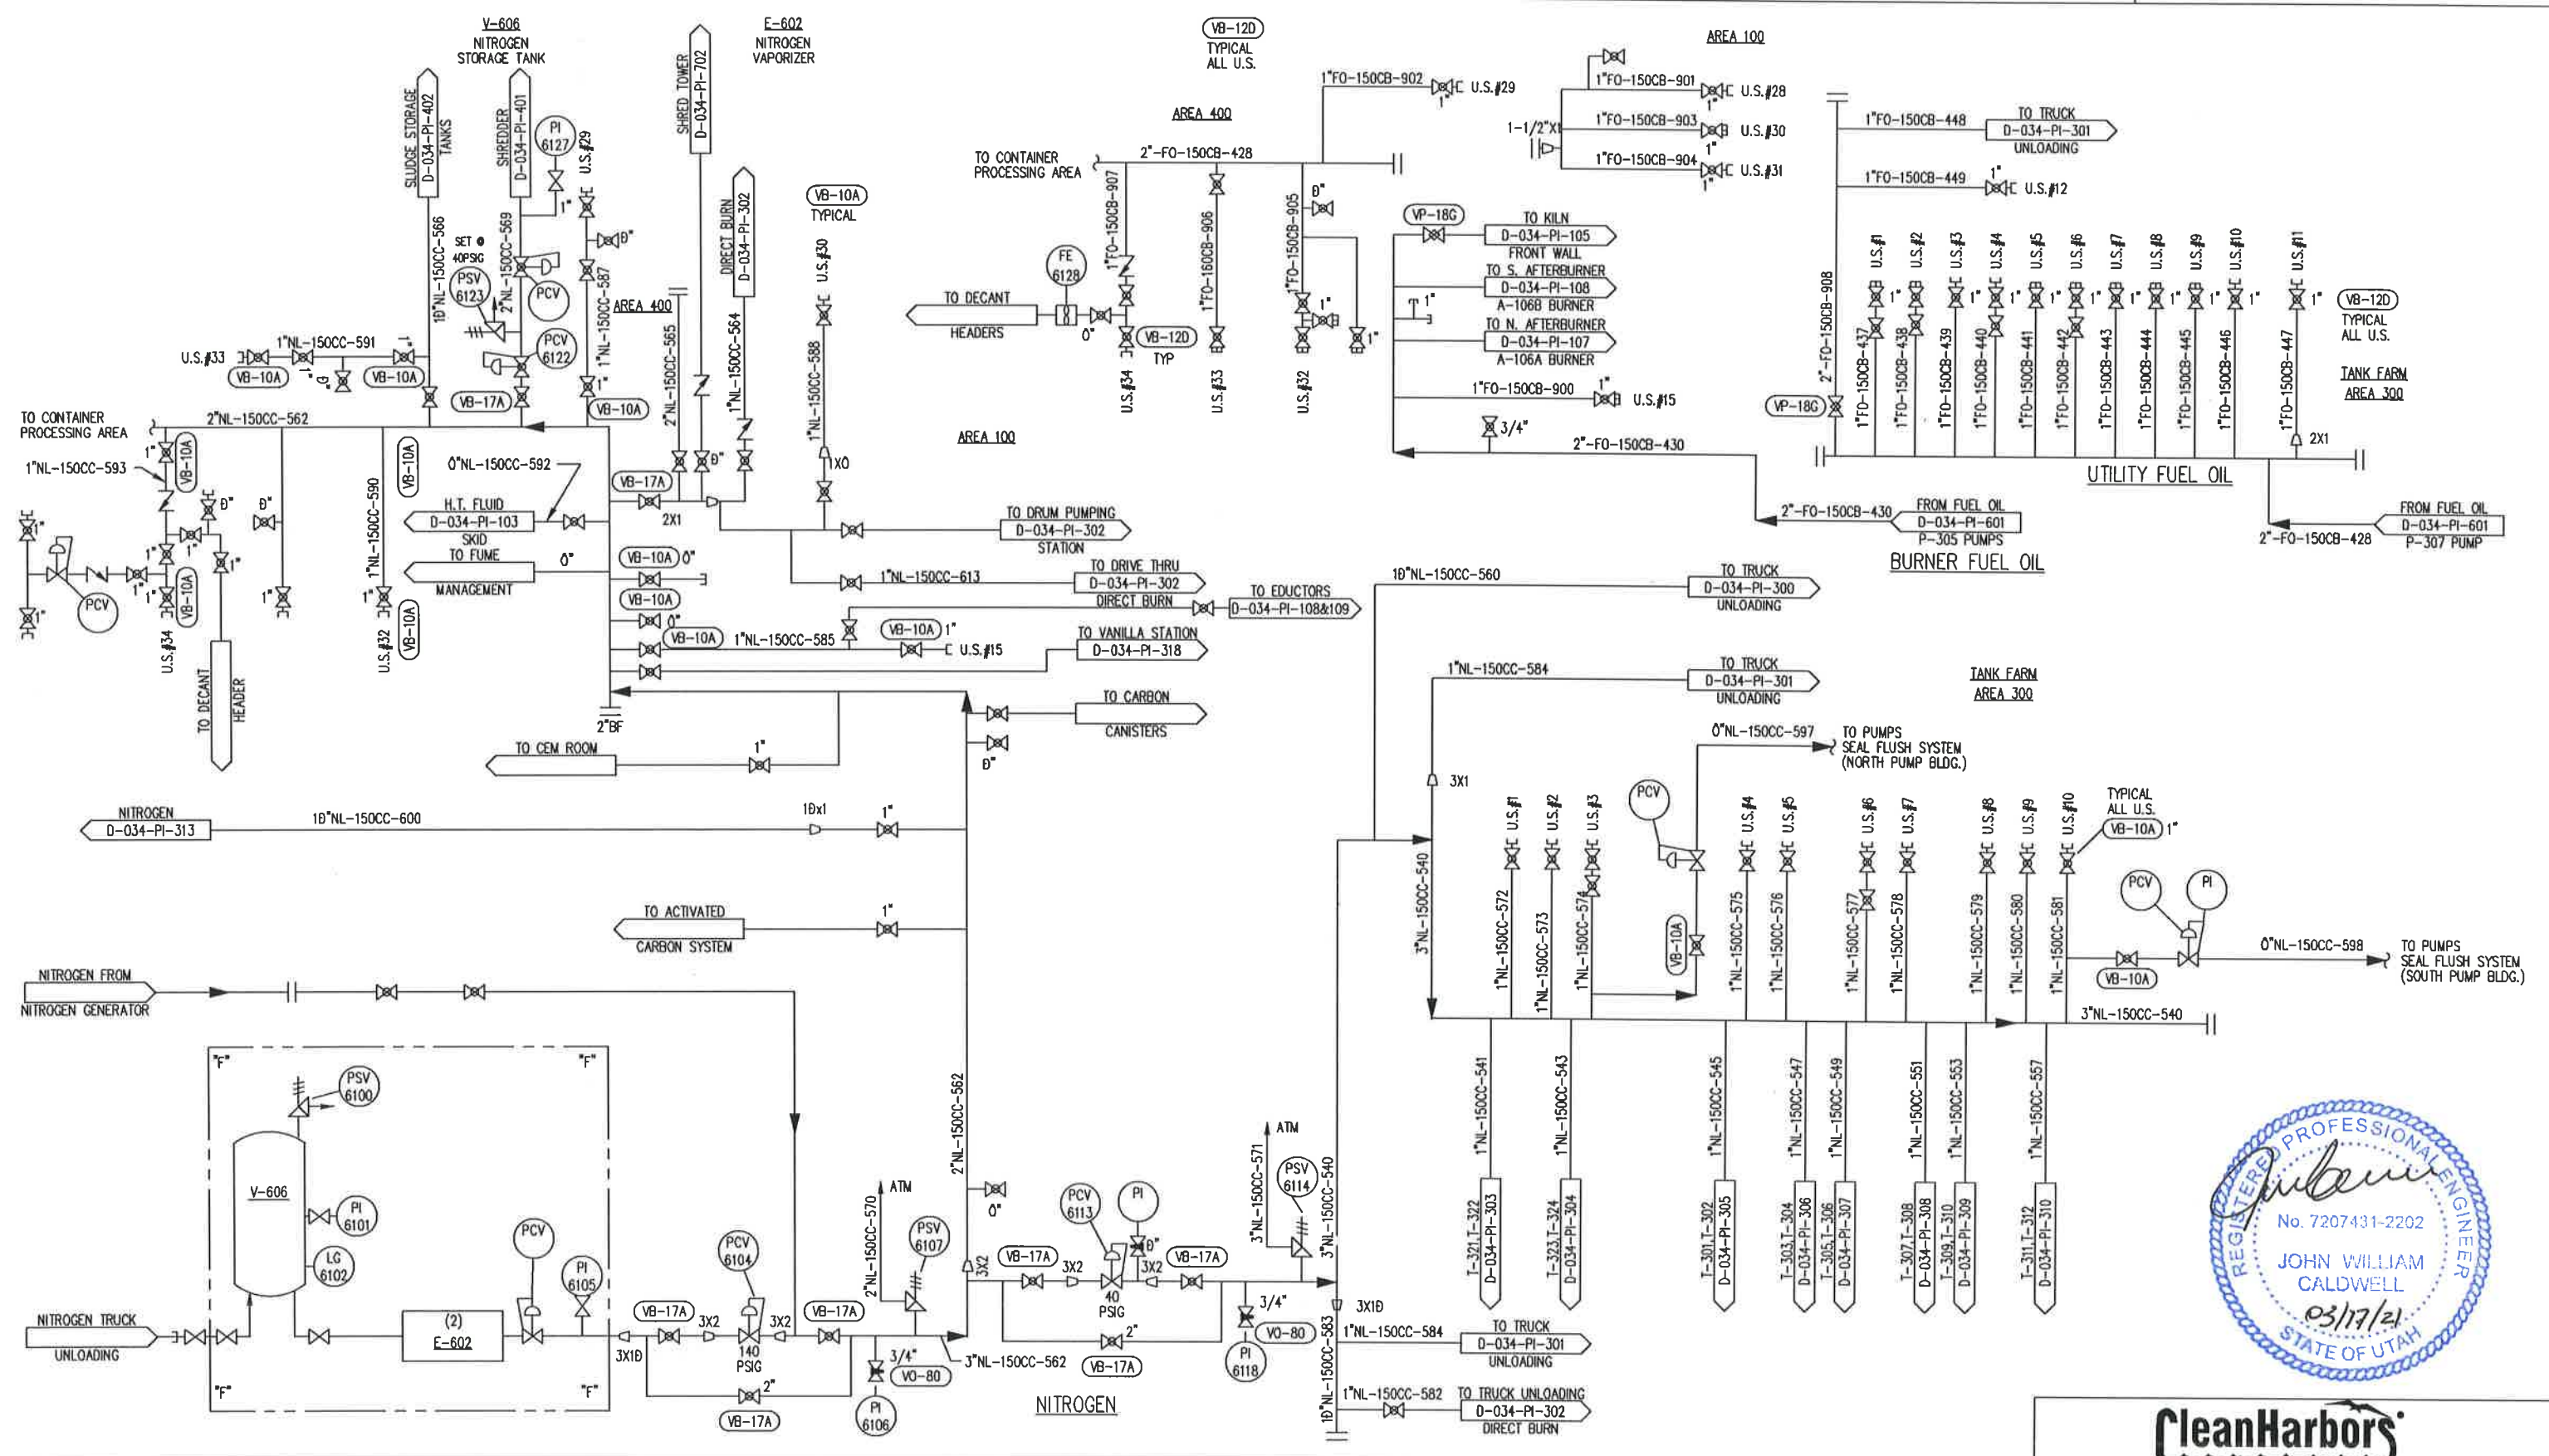

THIS DRAWING IS THE PROPERTY OF CLEAN HARBORS ARAGONITE, LLC. ANY INFORMATION CONTAINED HEREON MAY NOT BE COPIED OR USED WITHOUT WRITTEN PERMISSION OF CLEAN HARBORS ARAGONITE, LLC.

UTAH ENVIRONMENTAL SERVICE CENTER
INCINERATION PLANT FOR INDUSTRIAL WASTES
NITROGEN & FUEL OIL

INTERLOCK	
DESCRIPTION	

REVISIONS						
NO	DESCRIPTION	DATE	BY	CHK	ELEC	MECH
10	ADDED NITROGEN PIPING TO	06-06-03	KL			
11	EDUCTOR AND VANILLA STN, CORRECTIONS					
12	ADDED DRUM PUMPING N2 LINE	10-31-03	KL			
13	UTILITY MODIFIED FOR FUEL OIL BURNER					
14	FEED, PER MOC-16-0018, UPDATED N2 LINE	07-06-16	MM	CP		
15	REMOVE N2 LINE	11-19-18	JWR	TL		
16	ADDED N2 GEN, SHRED TOWER LINES	03-07-19	PEC			
17	AS-BUILT	03-16-21	KB	TH	SS	KB

REFERENCE DRAWINGS	
DRAWING NO	TITLE

APPROVALS	
BY	DATE

CURRENT DRAWING STATUS	
BY	DATE

REGISTERED PROFESSIONAL ENGINEER
DATE:

FOR TOOELE SITE	CAD DISK FILE	IH778
SCALE	JOB NO	ENG. DWG NO
		CLEANHARBORS DWG NO
		D-034-PI-605
		REV
		15