
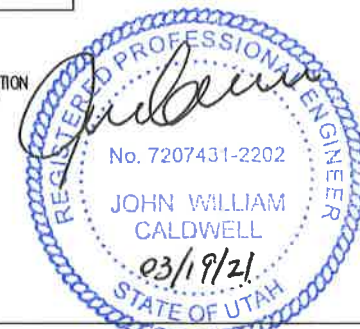


A
B
C
D

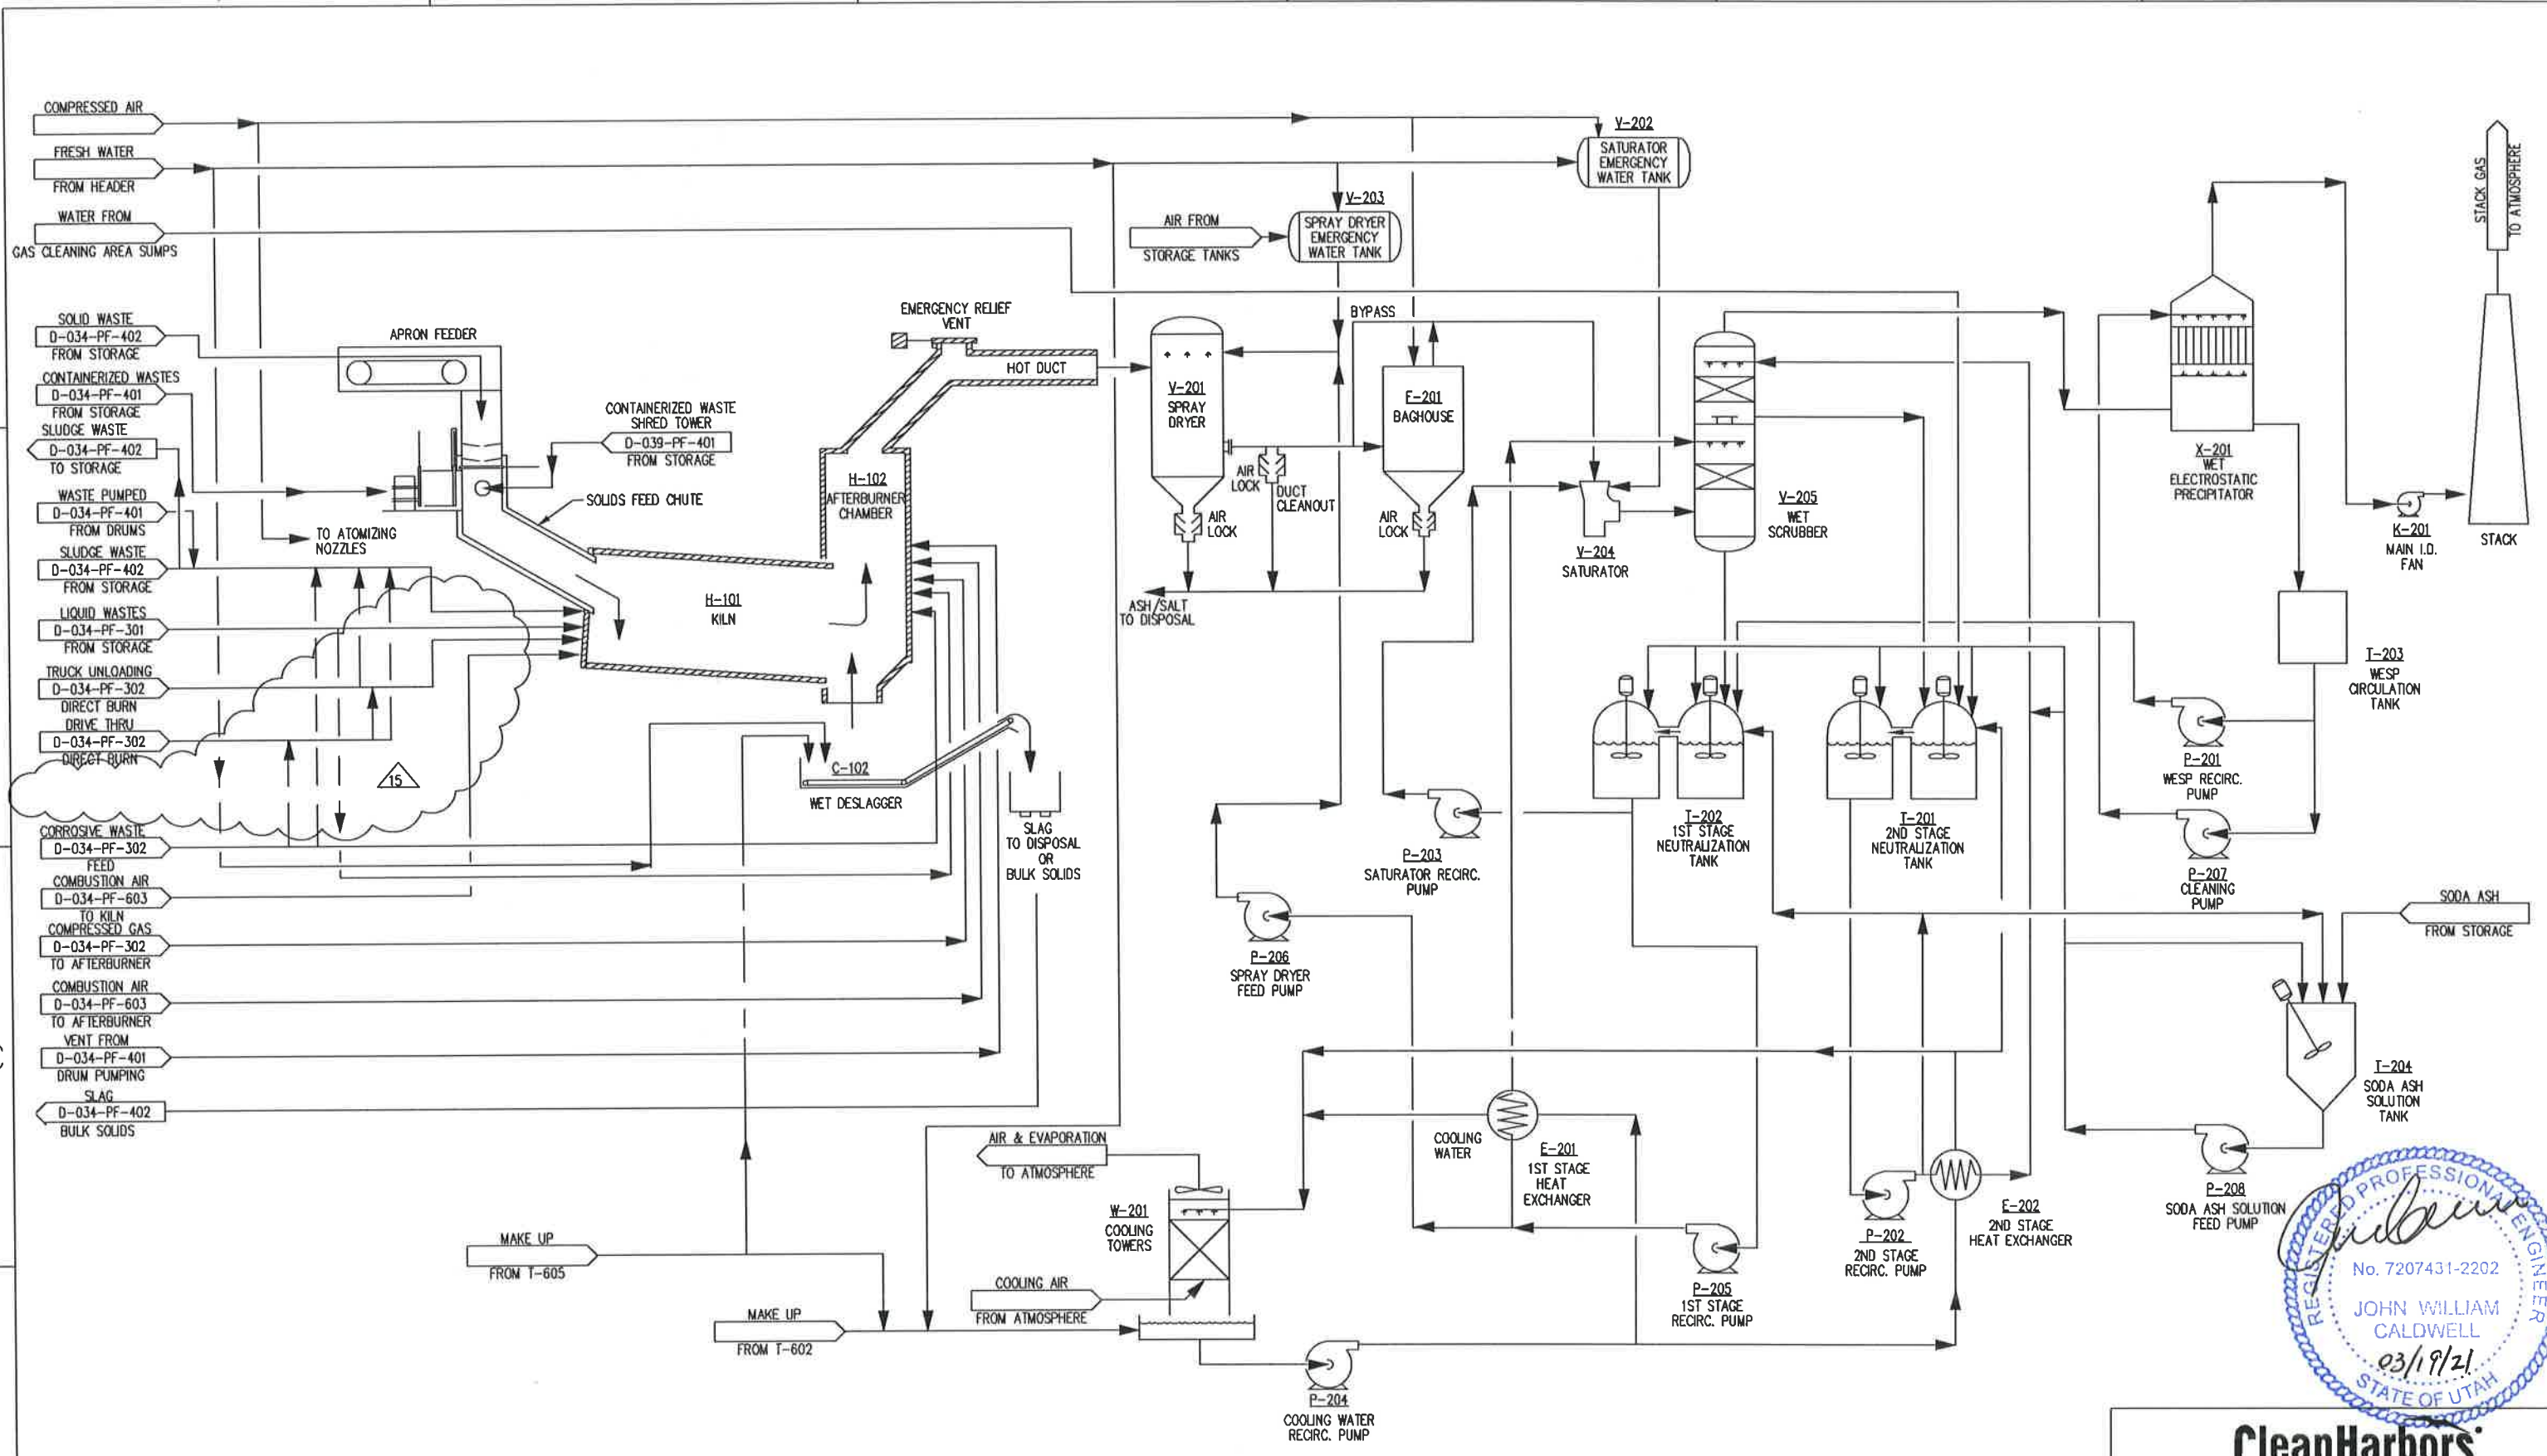

CleanHarbors
ARAGONITE LLC
THIS DRAWING IS THE PROPERTY OF CLEAN HARBORS ARAGONITE LLC
ANY INFORMATION CONTAINED HEREIN MAY NOT BE COPIED
OR USED WITHOUT WRITTEN PERMISSION OF OWNER.

TITLE
UTAH ENVIRONMENTAL SERVICE CENTER
INCINERATION PLANT FOR INDUSTRIAL WASTES
OVERALL FLOW SCHEME

FOR TOOELE SITE CAD NO. IH661J
SCALE JOB NO SAFETY-KLEEN DWG NO REV
D-034-PF-100 15

APPROVALS

BY	DATE
DP	03-12-20

DRAWN
CHECKED
ELEC.
MECH.
STRUCT.
PROJECT ENG.
ENGINEERING MGR.

AS BUILT

DRAWING NO	TITLE	NO	DESCRIPTION	DATE	BY	CHK	ENG MGR	NO	DESCRIPTION	DATE	BY	CHK	ENG MGR
		1	REVISED LABELS, ADDED DBV DIRECT BURN, CORRECTED WATER FLOW	04-16-03	KL			1	ADDED DUCT CLEANOUT	05-21-10	BAD		BAD
		2	ADDED COMPRESSED GAS FEED	06-06-03	KL			2	ADDED CONTAINERIZED WASTE FEED	03-07-19	PEC		
		3	ADDED DRUM PUMPING TO SLUDGE	11-03-03	KL			3	RMV DIRECT BURN VESSEL	03-19-21	KB	TH	KB
		4	ADDED CORROSIVE WASTE	12-06-07	KL			4	ADDED SLIDE GATE	7-13-00	GVC		
								5	ADDED TRUCK UNLOADING DIRECT BURN	03-28-02	GVC		

REGISTERED PROFESSIONAL ENGINEER
DATE: