
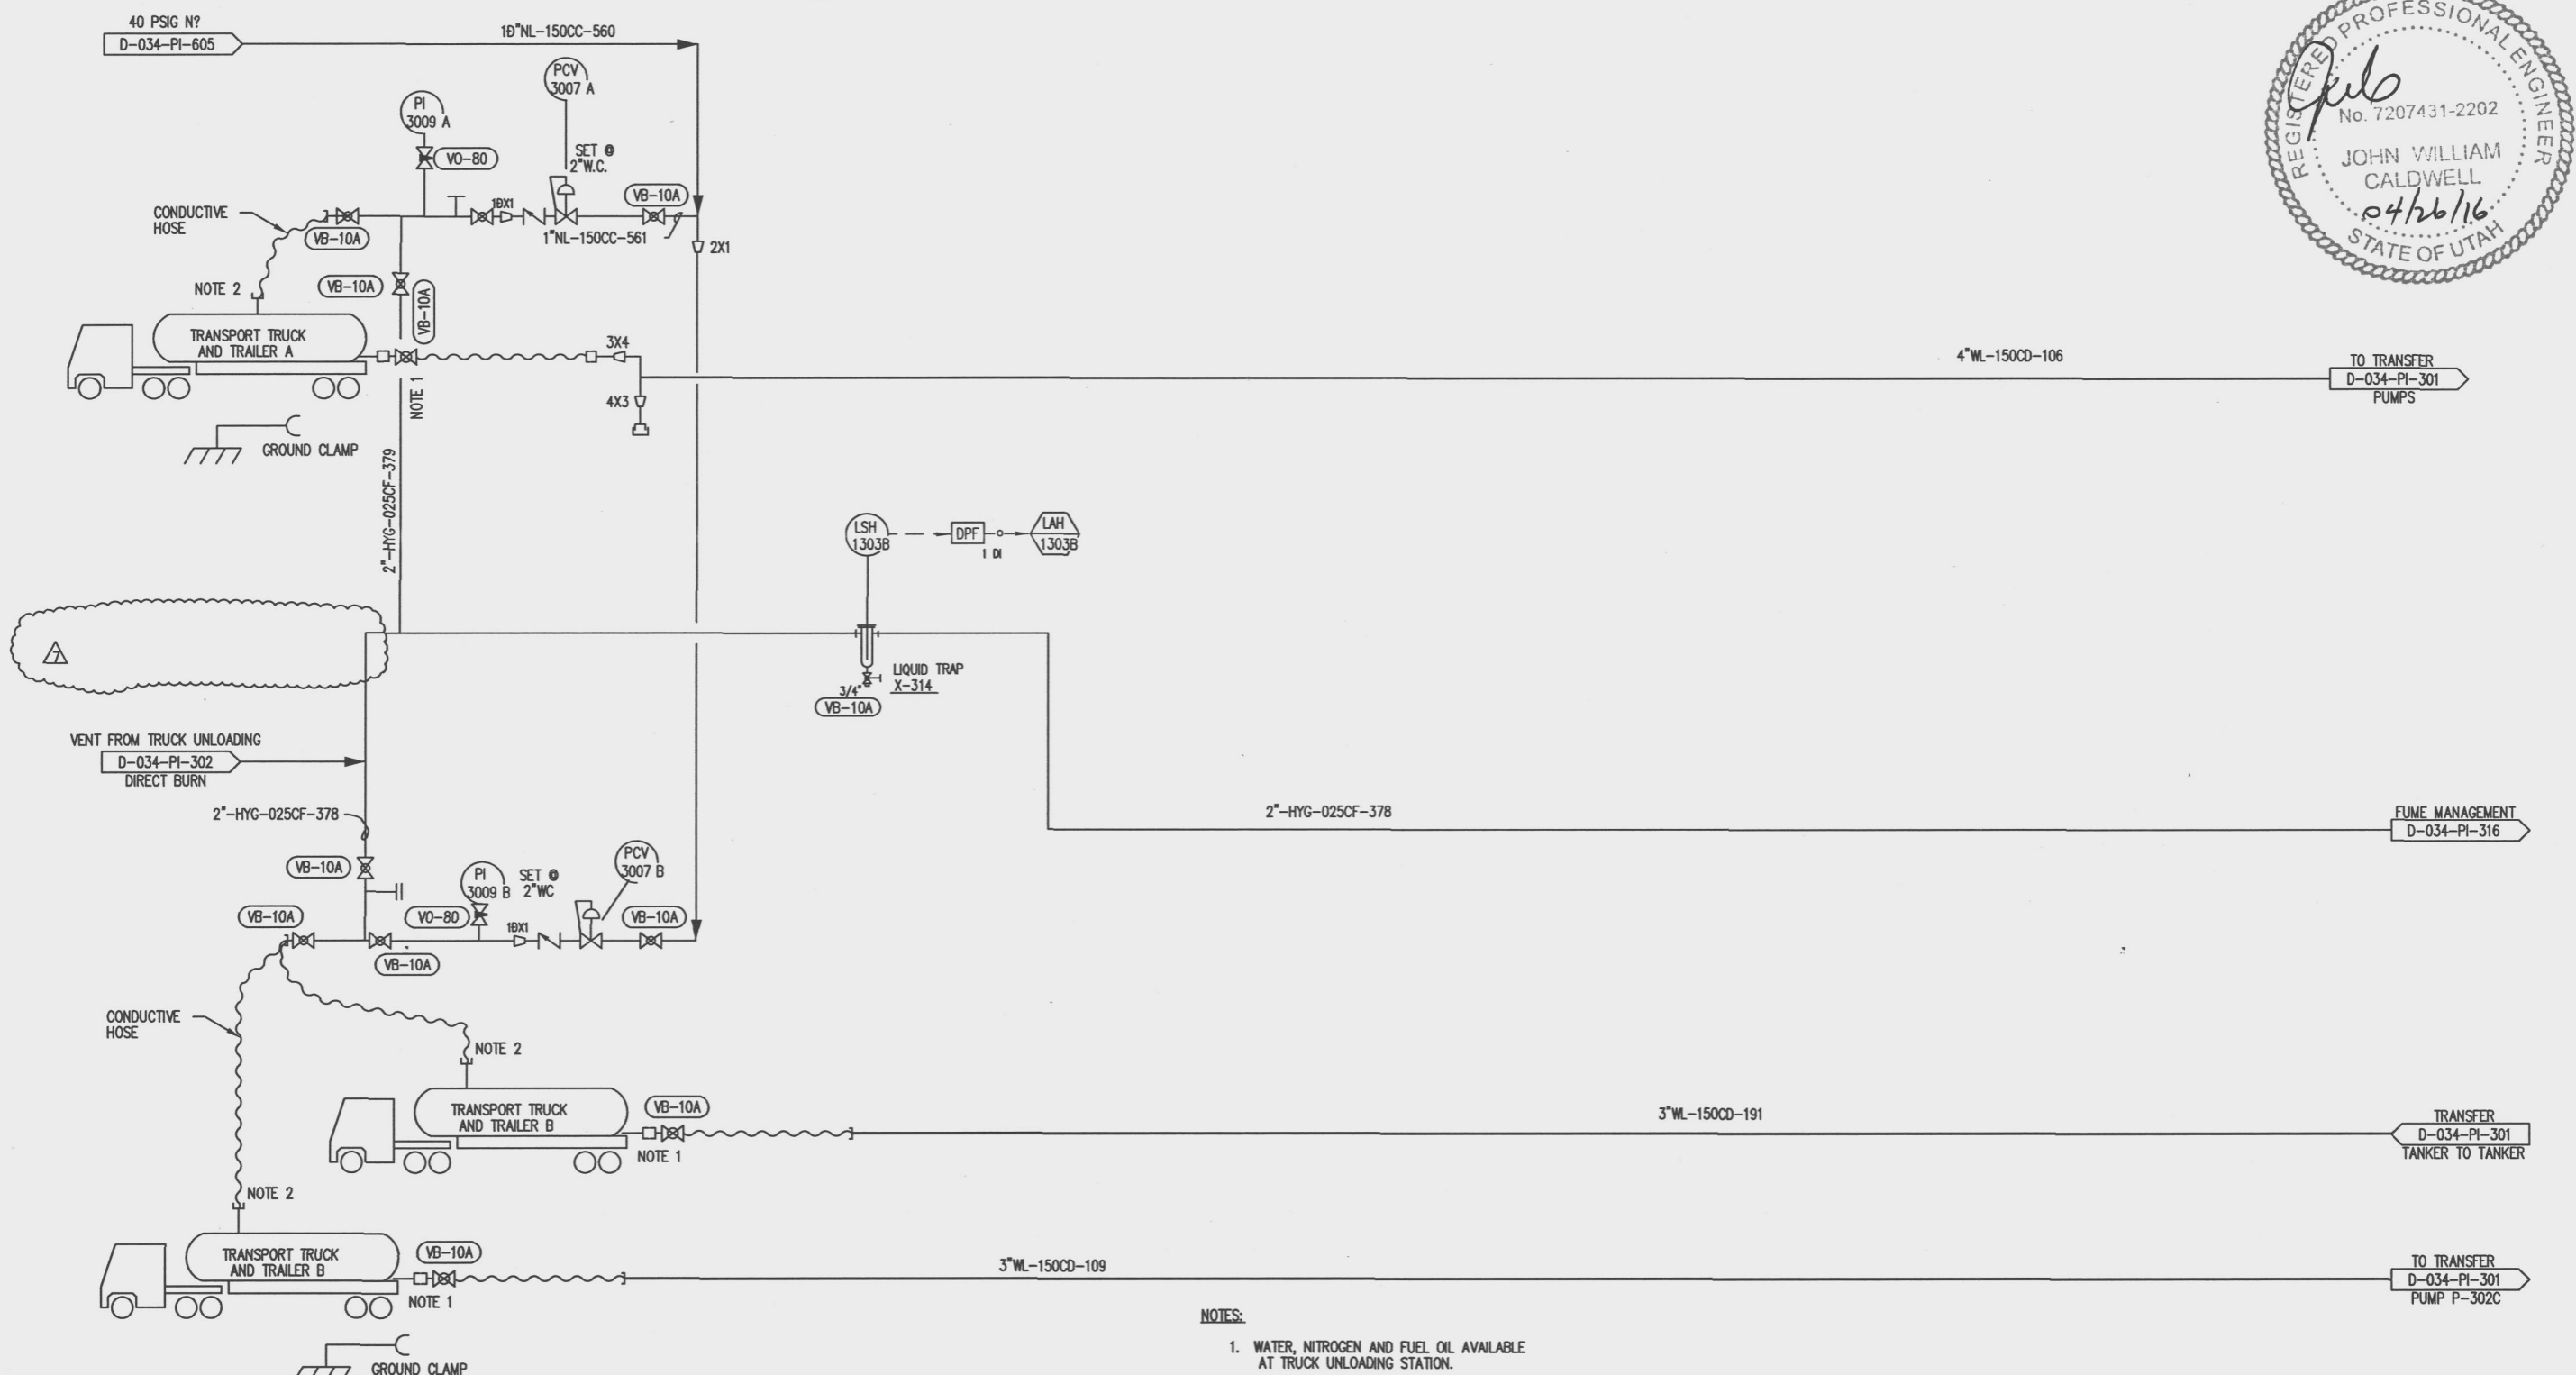


P-302A,B
TRUCK UNLOADING
PUMP

X-314
LIQUID TRAP

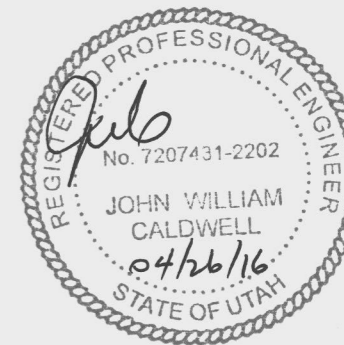

- NOTES:
1. WATER, NITROGEN AND FUEL OIL AVAILABLE AT TRUCK UNLOADING STATION.
 2. NITROGEN PURGE BY HOSE, IF REQUIRED BY OPERATING PROCEDURES.

INTERLOCK
DESCRIPTION

REVISIONS									
NO	DESCRIPTION	BY	CHK	LEAD ENG	ELEC	MECH	STR	PROJ ENG	PROJ MGR
1	ISSUED FOR CONSTRUCTION 07/07/89	MU							
2	REMOVED SLUDGE PAD VENT LINE REF 04-22-16	MM	LB						
3	AS BUILT 9-20-00	GVC							
4	ADDED TRANSFER TANKER TO TANKER 4-11-01	GVC							
5	ADDED TANKER DIRECT BURN AND REMOVED A-301 09-13-02	KL							

REFERENCE DRAWINGS	
DRAWING NO	TITLE

REGISTERED PROFESSIONAL ENGINEER
DATE: _____

APPROVALS		CURRENT DRAWING STATUS	
BY	DATE	BY	DATE
DRAWN	CRM 2-30-96	PRELIMINARY OR PLANNING	KRP 2-17-88
CHECKED		APPROVED FOR FINAL DESIGN	
LEAD ENG.		APPROVED FOR QUOTE/PURCH	
ELEC CHECK		APPROVED FOR CONSTRUCTION	
MECH CHECK		AS-BUILT	
STRUCT CHECK			
PROJECT ENG			
PROJECT MGR			

CleanHarbors
ARAGONITE LLC

THIS DRAWING IS THE PROPERTY OF CLEAN HARBORS ARAGONITE LLC. ANY INFORMATION CONTAINED HEREON MAY NOT BE COPIED OR USED WITHOUT WRITTEN PERMISSION OF OWNER.

UTAH ENVIRONMENTAL SERVICE CENTER
TRUCK UNLOADING AREA
P&ID LIQUID UNLOADING PUMPS

FOR CLEAN HARBORS	CAD DISK FILE	11635
SCALE NONE	JOB NO W6068R	ENG. DWG NO APTUS DWG NO D-034-PI-300
		REV 7