


INTERLOCK DESCRIPTION	
NO	DESCRIPTION
1	ISSUED FOR CONSTRUCTION
2	AS BUILT UPDATE
3	NEW NITROGEN LINES
4	ADDED F-309 STRAINER
5	AS BUILT

REVISIONS						
NO	DESCRIPTION	DATE	BY	CHK	ENG MGR	NO
1	ISSUED FOR CONSTRUCTION	07-07-89	MU	IRB	JV	1
2	AS BUILT UPDATE	01-05-94	DCP	GVC		2
3	NEW NITROGEN LINES	03-01-94	DCP			3
4	ADDED F-309 STRAINER	06-27-96	DCP			4
5	AS BUILT	12-10-96	CRM			5

REVISIONS						
NO	DESCRIPTION	DATE	BY	CHK	ENG MGR	NO
1	TO CORRECT DRAFTING ERRORS	04-08-98	CRM			1

APPROVALS		
DRAWN	BY	DATE
CHECKED	CRM	12-10-96
ELEC		
MECH		
STRUCT		
PROJECT ENG		
ENGINEERING MGR		
AS BUILT		

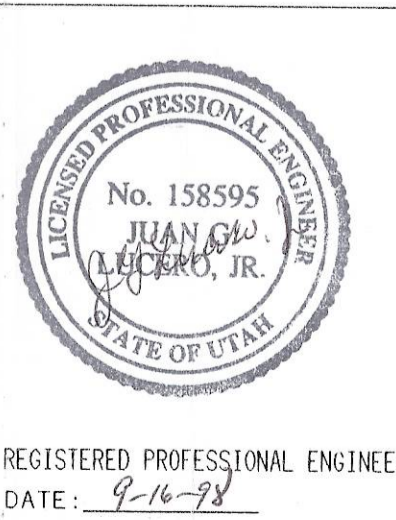

LAI DLAW
 ENVIRONMENTAL SERVICES (ARAGONITE), INC.
 11600 NORTH APTUS ROAD, ARAGONITE, UT. 84029

TITLE
 UTAH ENVIRONMENTAL SERVICE CENTER
 INCINERATION PLANT FOR INDUSTRIAL WASTES
 P&ID AQUEOUS FEED PUMPS

FOR TOOLEE SITE CAD NO. IH755M
 SCALE JOB NO APTUS DWG NO
 D-034-PI-315 5

REGISTERED PROFESSIONAL ENGINEER
 DATE: 9-16-98