



LEGEND
 BV-BALL VALVE
 SPC-SAMPLE PRECOOLER
 CS-CONDENSATE SEPARATOR
 CP-CONDENSATE PUMP
 FI-FLOW INDICATOR
 NV-NEEDLE VALVE
 SP-SAMPLE PUMP
 SD-SAMPLE DRYER
 PRV-PRESS REGULATING VALVE
 PI-PRESSURE INDICATOR
 CM-CONDENSATE MONITOR
 SV-SOLENOID VALVE
NOTES:
 1. THIS DRAWING WAS ORIGINALLY CREATED BY ROSEMOUNT ANALYTICAL INC. AND REVISED BY APTUS INC.

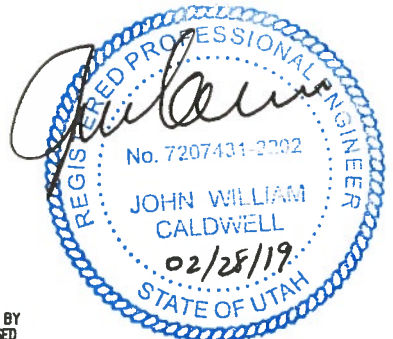

CALIBRATION GAS BOTTLES W/DUAL STAGE REGULATORS

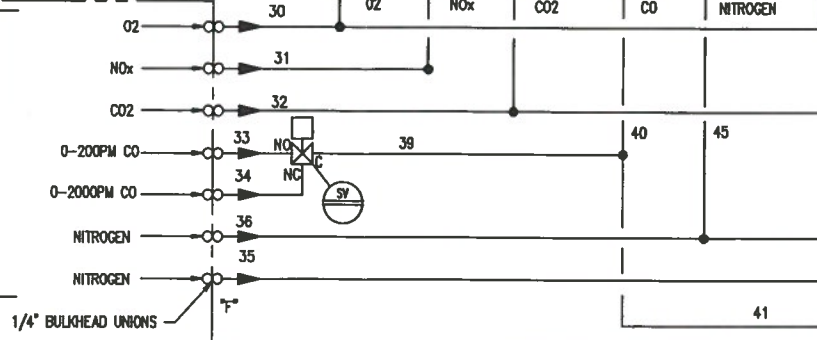

REFERENCE DRAWINGS		REVISIONS					REVISIONS					APPROVALS		CleanHarbor								
DRAWING NO	TITLE	NO	DESCRIPTION	DATE	BY	CHK	ENG MGR	NO	DESCRIPTION	DATE	BY	CHK	ENG MGR	BY	DATE	FOR	TITLE	CAD NO.	SCALE	ROSEMOUNT DWG. NO.	APTUS DWG NO	REV
		1	CHANGE DWG. FROM AP464A TO D-800-PI-215	04-18-00	GVC												UTAH ENVIRONMENTAL SERVICE CENTER	AP464D	NA	3038358	D-800-PI-215	4
		2	AS BUILT	04-27-00	KGB																	
		3	CHANGE DWG. FROM AP464B TO AP464C	09-16-02	KL																	
		4	ADDED SO2 AND THC ANALYZERS	10-23-03	LCC																	

CleanHarbor
 UTAH ENVIRONMENTAL SERVICE CENTER
 PIPING DIAGRAM
 CEM #1 SYSTEM
 FOR TOOLEE SITE
 SCALE NA
 CAD NO. AP464D
 APTUS DWG NO D-800-PI-215
 REV 4