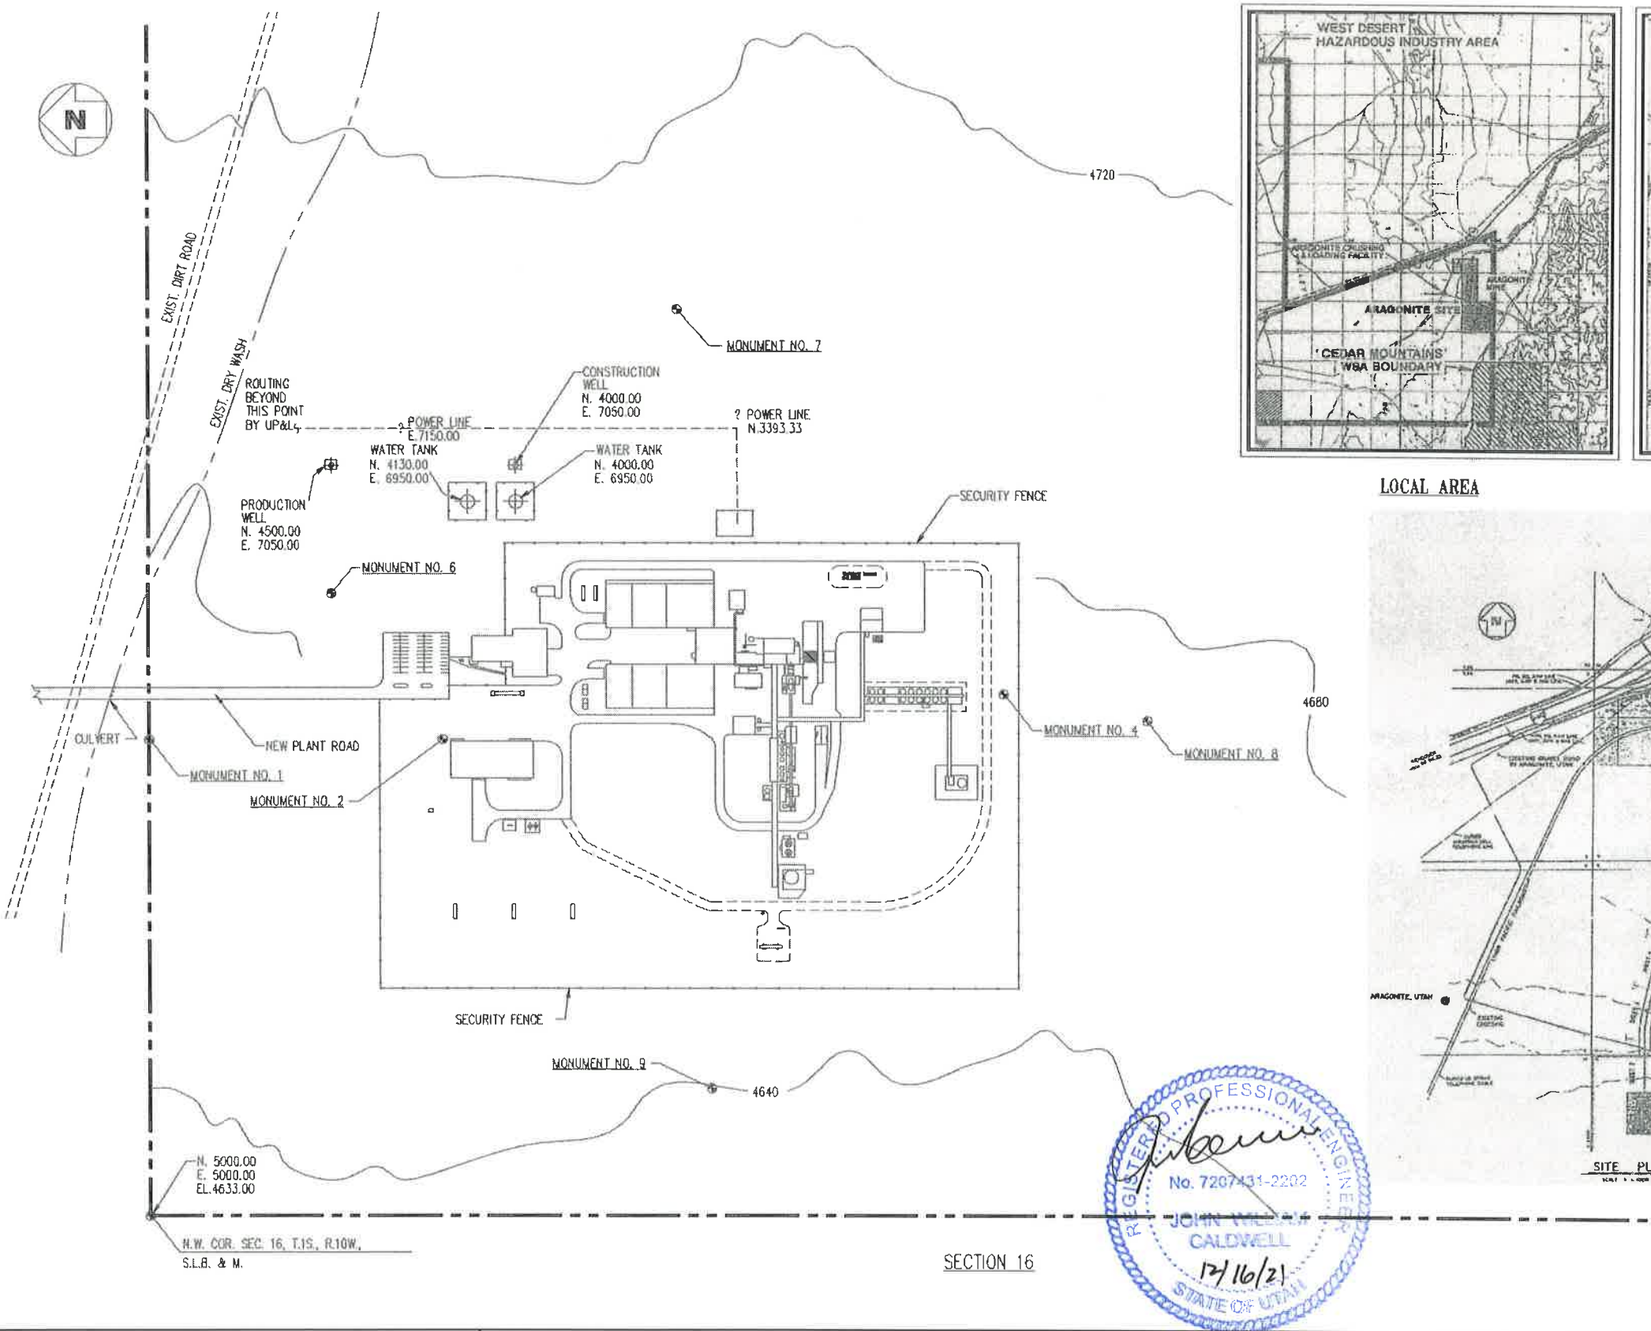

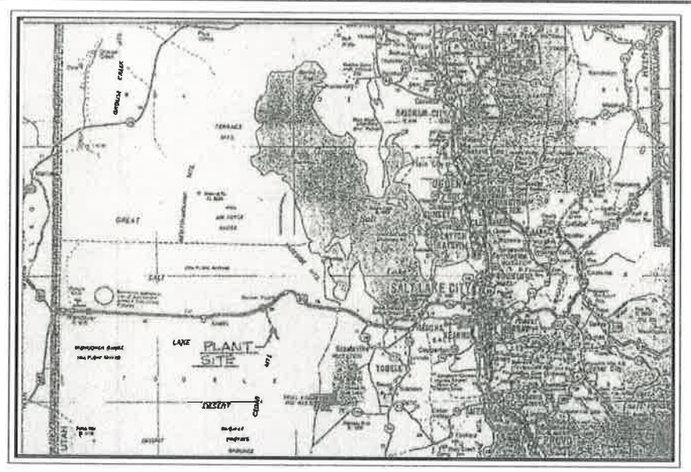

LOCAL AREA

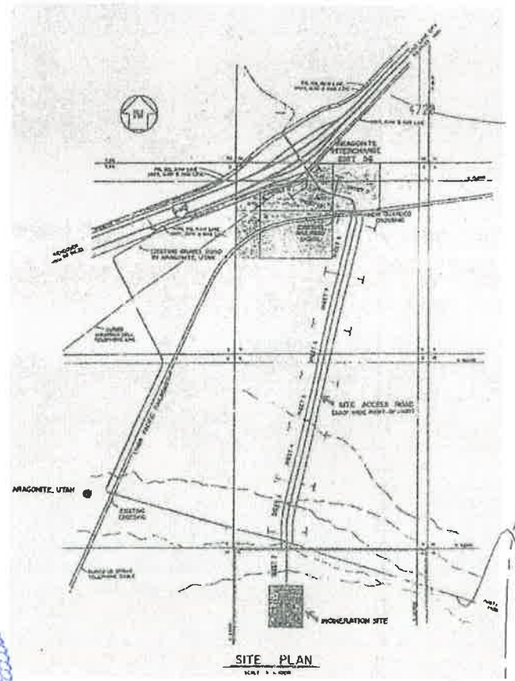

SITE PLAN

HIGHWAY MAP

NOTES:

1. TOPOGRAPHY SHOWN WAS TAKEN FROM U.S.G.S. QUADRANGLE "HASTINGS PASS, UTAH, 1973".
2. NOT IN 100 YEAR FLOOD PLAIN. HIGHEST RECORDED LEVEL OF GREAT SALT LAKE, ELEVATION 4,217 FEET MEAN SEA LEVAL.
3. BASIS OF BEARINGS IS EAST FROM NORTHWEST CORNER OF SECTION 16, T.1 S., R. 10 W., S.L.B.&M. TO THE NORTHEAST CORNER OF SAID SECTION 16.
4. BENCHMARK IS APPROXIMATE ASSUMED U.S.G.S. DATUM FROM NORTHWEST CORNER OF SAID SECTION 16.
5. PLANT ELEVATION DATUM 100'-0" EQUALS U.S.G.S ELEVATION DATUM 4,682'-0".
6. FOR SURVEY CONTROL MONUMENT DATA, SEE R&M DRAWING NUMBER 8936-1.
7. LAND DESCRIPTION:

   A TRACT OF LAND LYING IN TOOELE COUNTY, STATE OF UTAH, SECTION 16, TOWNSHIP ONE (1) SOUTH, RANGE TEN WEST, SALT LAKE MERIDAN AND BASE LINE, CONTAINING 640 ACRES MORE OR LESS, ACCORDING TO THE UNITED STATES SURVEY.

SCALE
100 200 400 600
(FEET)
1" = 200'

REGISTERED PROFESSIONAL ENGINEER
No. 7207431-2202
JOHN WESLEY CALDWELL
12/16/21
STATE OF UTAH

REVISIONS									REVISIONS									REFERENCE DRAWINGS	
NO	DESCRIPTION	DATE	BY	CHK	ELEC	MECH	STR	PROJ MGR	NO	DESCRIPTION	DATE	BY	CHK	ELEC	MECH	STR	PROJ MGR	DRAWING NO	TITLE
0	APPROVED FOR CONSTRUCTION	7-21-89							7	MOVE BLDG 68 & 69	03-03-21	KB	TH				KB	D-034-M-002	PLANT PLOT PLAN
1	ADDED MONUMENTS	1-5-90	RLJ					JV	8	ADD SHRED TOWER	03-04-21	KB	TH				KB	8936-1 (R&M)	OFF SITE FACILITIES
2	AS BUILT	07-01-91	DCP						9	ADD EXPLOSIVES STORAGE	04-05-21	KB	TH				KB		
3	ADDED NEW BUILDINGS	05-06-16	MM						10	AS BUILT (MODULAR BUILDINGS)	12-10-21	KB	TH				KB		
4	ADDED NEW WATER TANK	12-6-17	GBS																
5	ADD NEW RAW WTR TK/RMV POT WTR TK	02-15-19	JWR					JWR											
5	CLASS 4 MAGAZINE STORAGE																		
6	ADD SHRED TWR., MOVE EDUCT STA.	10-05-20	KB	TH				KB											

REGISTERED PROFESSIONAL ENGINEER
DATE: _____

APPROVALS	BY	DATE
DRAWN		
CHECKED		
LEAD ENG.		
ELEC CHECK		
MECH CHECK		
STRUCT CHECK		
PROJECT ENG		
PROJECT MGR		

CURRENT DRAWING STATUS	BY	DATE
PRELIMINARY OR PLANNING		
APPROVED FOR FINAL DESIGN		
APPROVED FOR QUOTE/PURCH		
APPROVED FOR CONSTRUCTION		
AS-BUILT		

CleanHarbors®
ARAGONITE LLC

THIS DRAWING IS THE PROPERTY OF CLEAN HARBORS ARAGONITE, LLC ANY INFORMATION CONTAINED HEREON MAY NOT BE COPIED OR USED WITHOUT WRITTEN PERMISSION OF OWNER.

TITLE
UTAH ENVIRONMENTAL SERVICE CENTER
INCINERATION PLANT FOR INDUSTRIAL WASTES
SITE PLAN

FOR TOOELE SITE | CAD DISK FILE MK966

SCALE	JOB NO	END. DWG NO	APTUS DWG NO	REV
1"= 200'			D-034-M-001	11