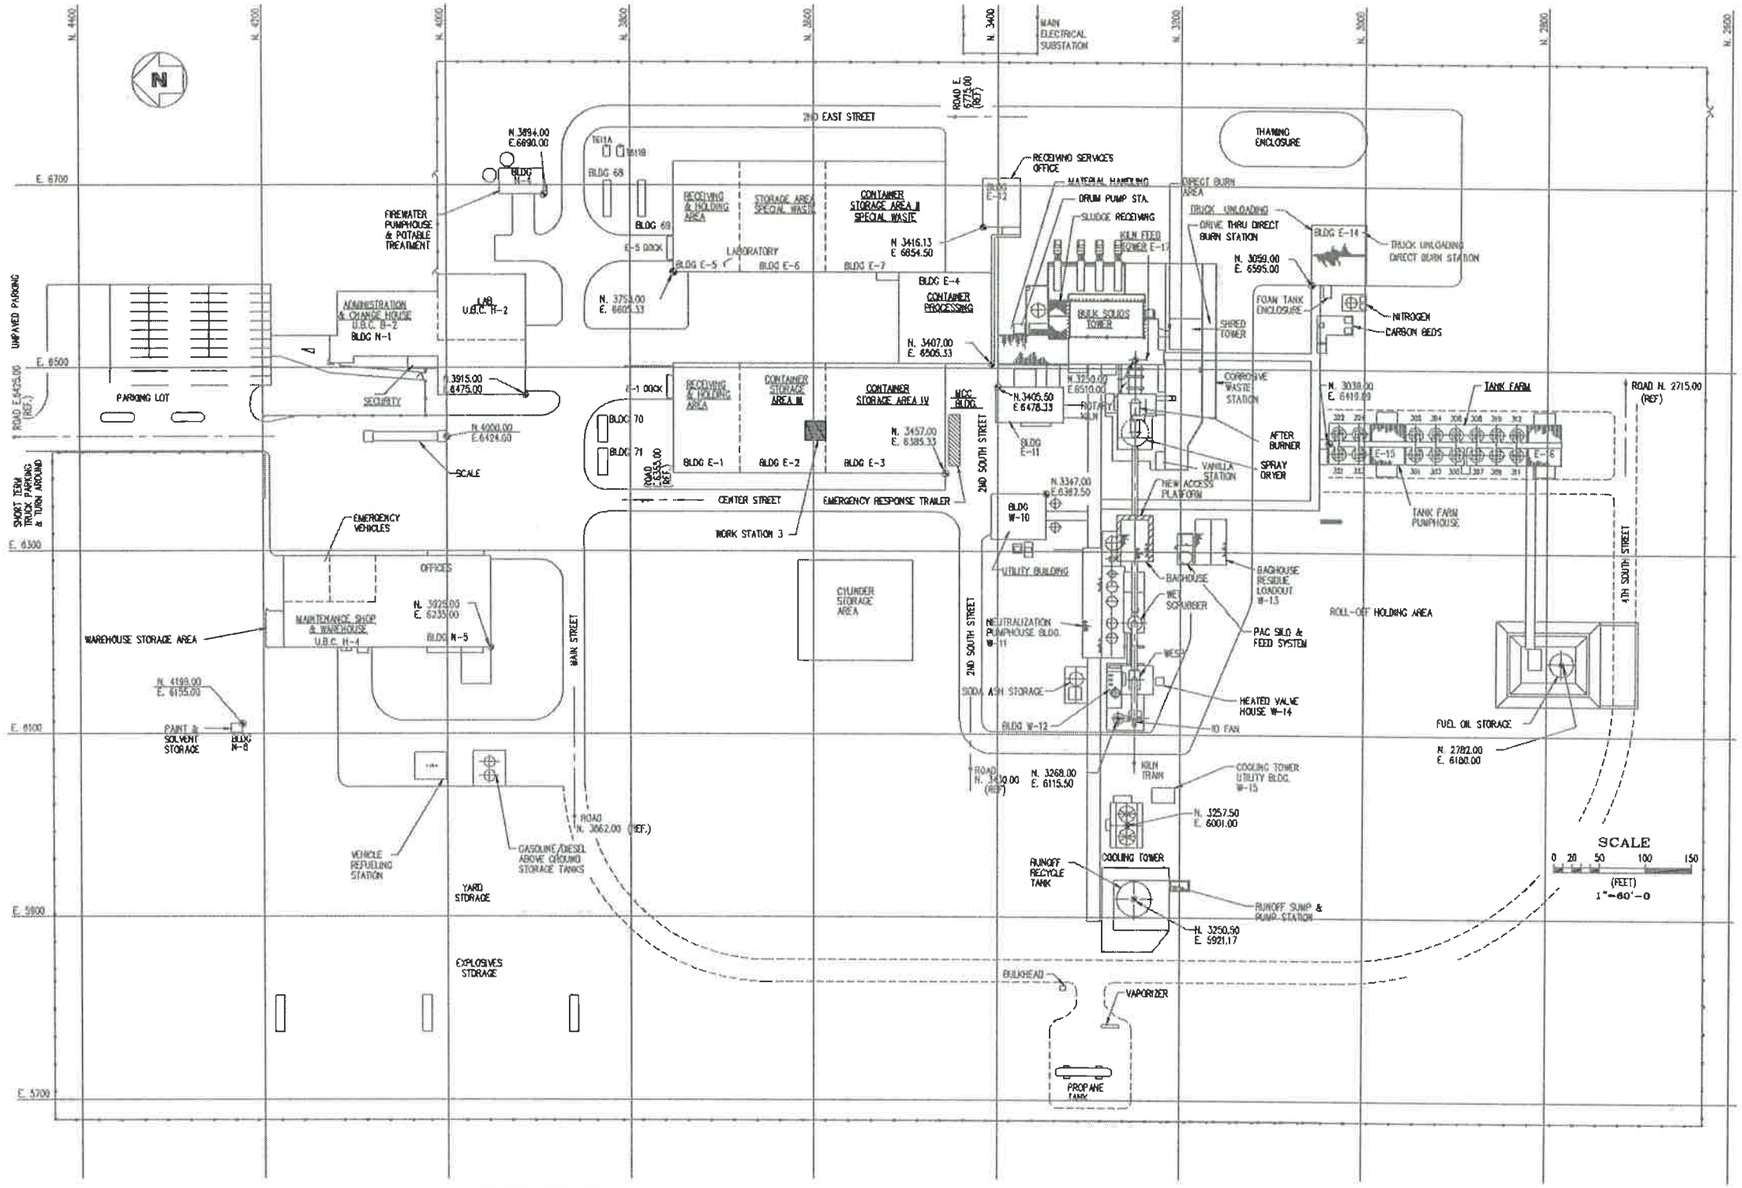

PLOT PLAN

REGISTERED PROFESSIONAL ENGINEER
No. 7207431-2202
JOHN WILLIAM CALDWELL
12/16/21
STATE OF UTAH

NOTES:

REVISIONS

NO	DESCRIPTION	DATE	BY	CHK		ENG MGR
15	DELETE FUTURE BLDGS E-8 & E-9	04/16/12	TJK			
14	ADDED NEW WATER TANK	12-6-17	GBS			
13	MOVE EDUCT STA., ADD CONEX, MV. 68 & 69	10-05-20	KB	TH	MM	KB
12	ADD E-8 BLDG, ADD 70 & 71 BLDG					
11	MOVE BLDG 68, 69, ADD BLDG 70, 71	03-03-21	KB	MM	TH	KB

REVISIONS

NO	DESCRIPTION	DATE	BY	CHK		ENG MGR
20	ADDED SHRED TOWER AREA	03-04-21	KB	TH	MM	KB
20	ADDED EXPLOSIVES MAGAZINES	04-06-21	KB	TH	MM	KB
21	AS-BUILT	12-10-21	KB	TH		KB
21	RELOCATE T611, AS BUILT BLDGS 68 & 69	10-05-11	TJK			TJK
22	ADD BLDG 69 N & S; DELETE ROLLOFF PAD	03-22-12	TJK			

APPROVALS

	BY	DATE
DRAWN	CRN	12-31-96
CHECKED		
ELEC		
MECH		
STRUCT		
PROJECT ENG		
ENGINEERING MGR		
AS BUILT		

REGISTERED PROFESSIONAL ENGINEER
DATE:_____

CleanHarbors
ARAGONITE LLC

THIS DRAWING IS THE PROPERTY OF CLEAN HARBORS ARAGONITE LLC AND ANY INFORMATION CONTAINED HEREON MAY NOT BE COPIED OR USED WITHOUT WRITTEN PERMISSION OF OWNER.

TITLE
UTAH ENVIRONMENTAL SERVICE CENTER
INCINERATION PLANT FOR INDUSTRIAL WASTES
PLOT PLAN

FOR	CAD NO.
TOOELE SITE	MK409AK
SCALE: AS NOTED	JOB NO:
APTUS DWG NO: D-034-M-002	REV: 31