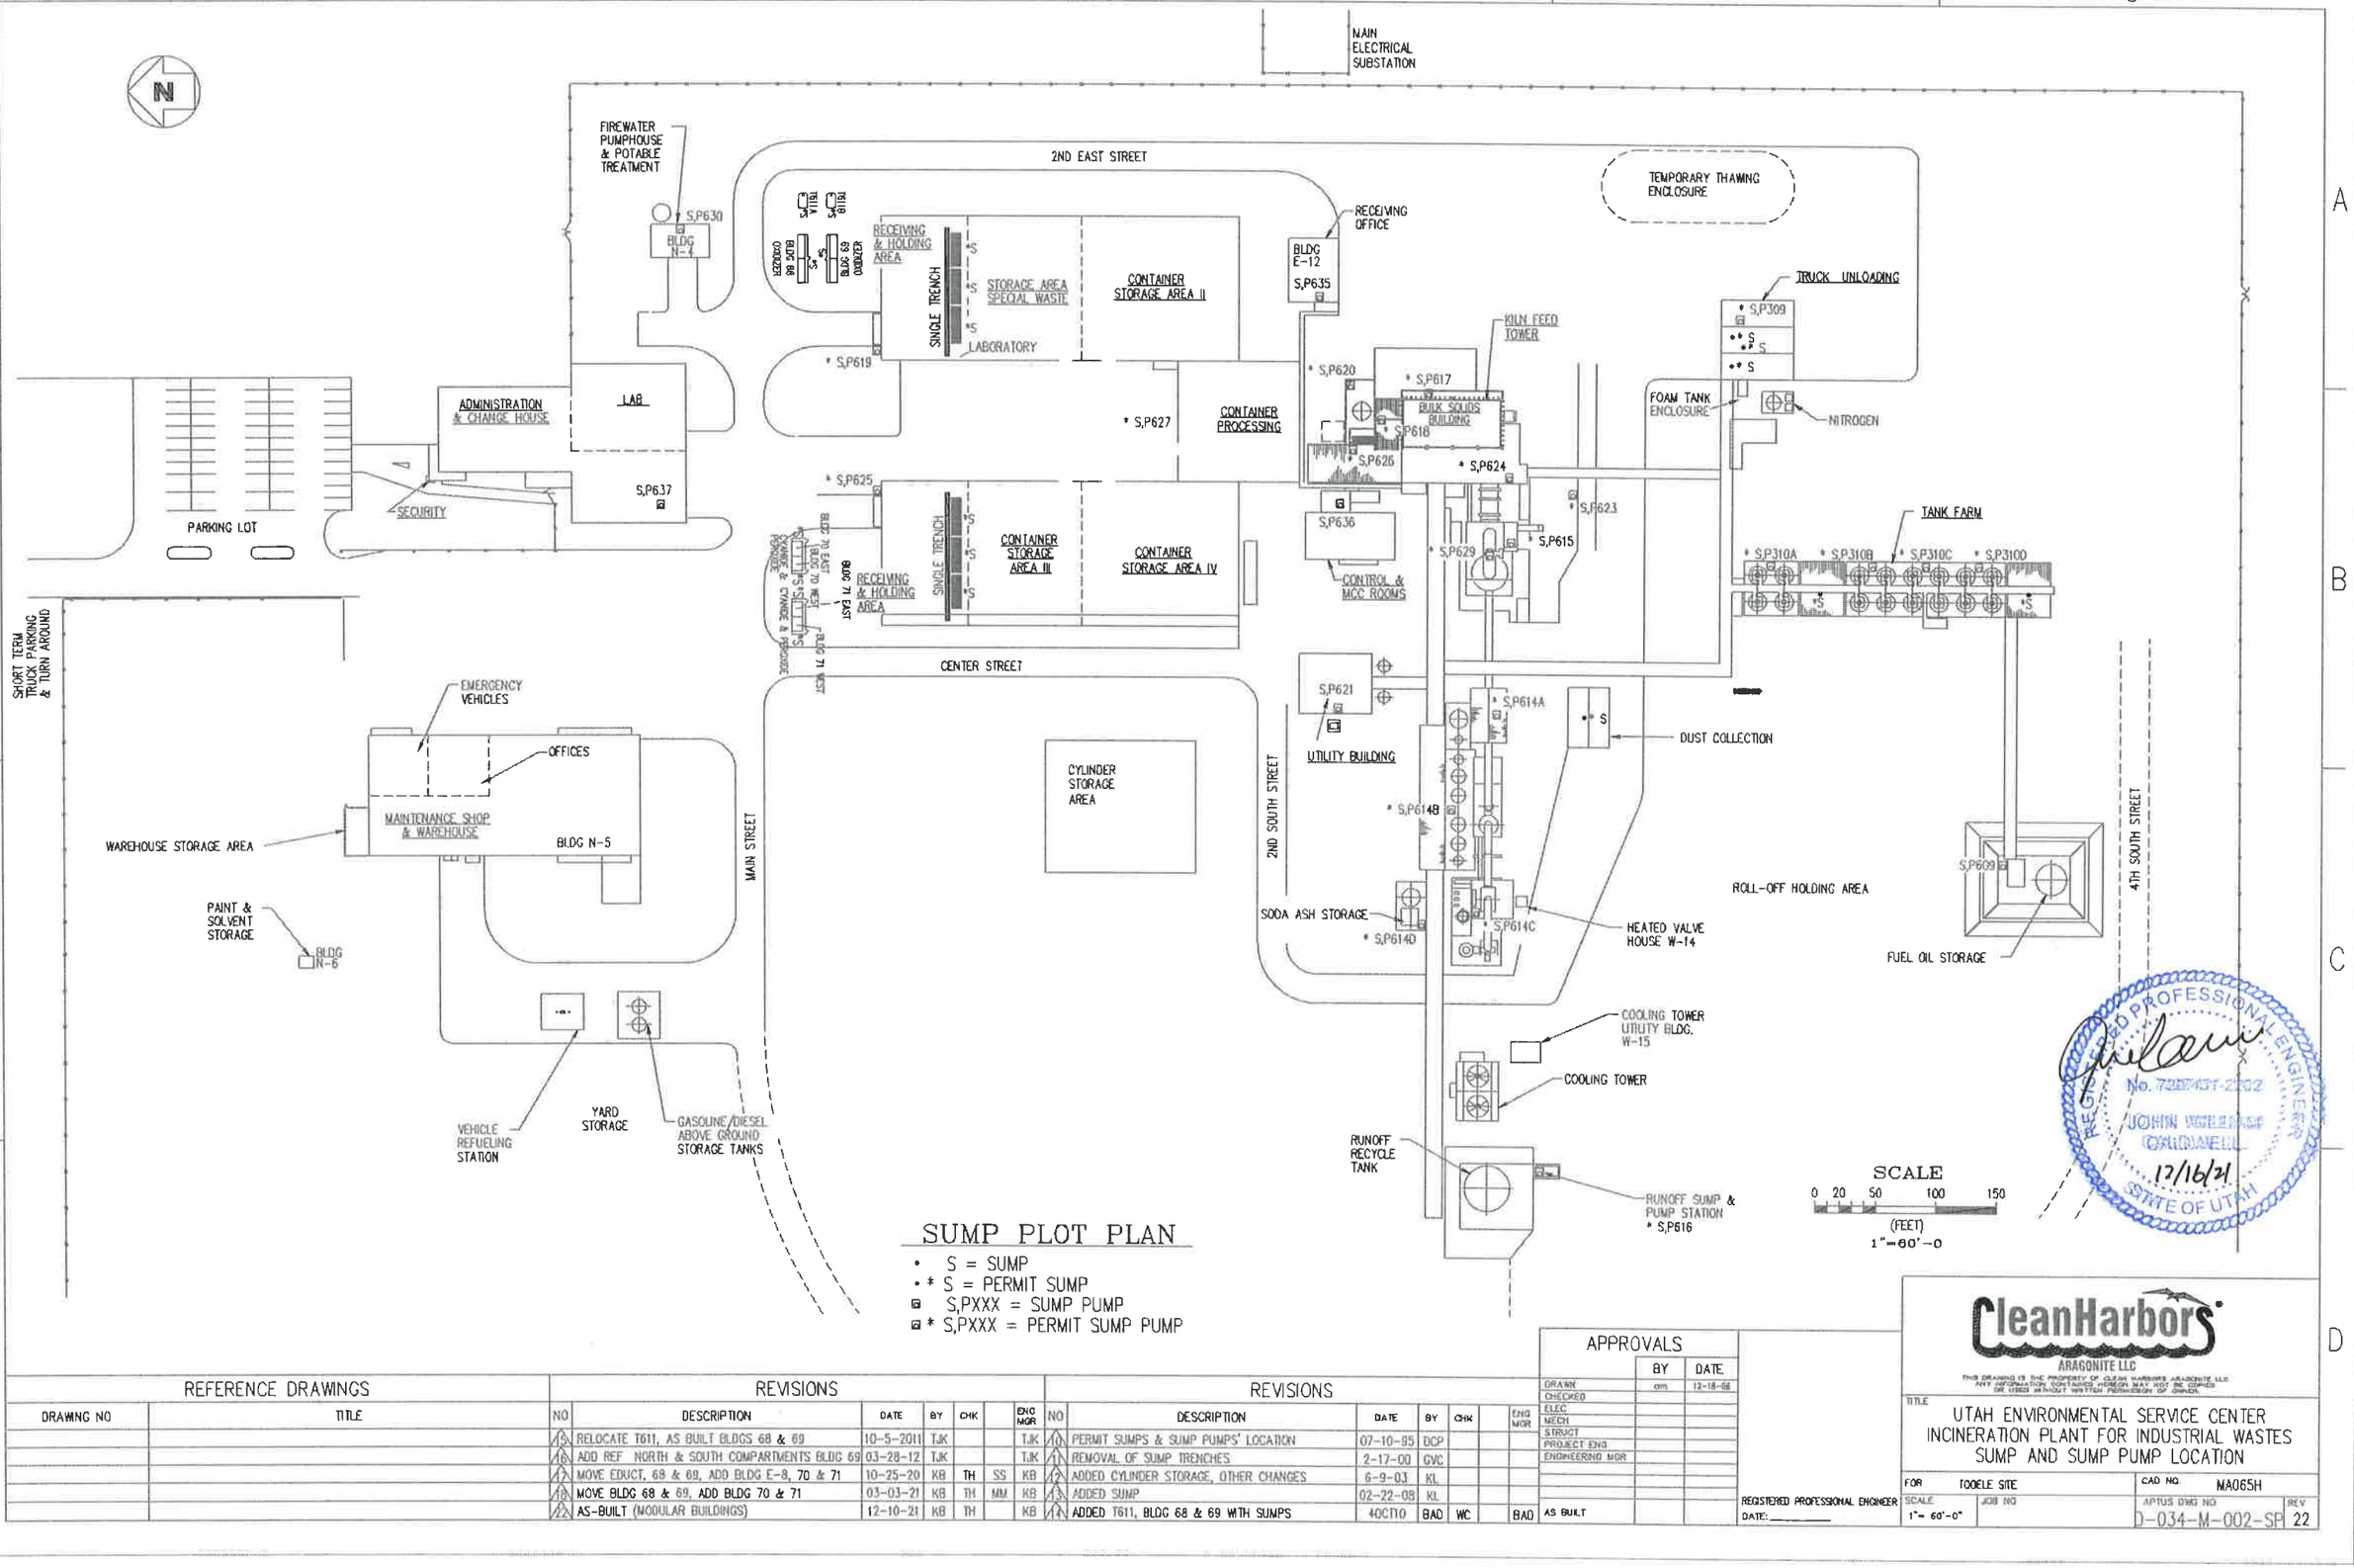

SUMP PLOT PLAN

- • S = SUMP
- • * S = PERMIT SUMP
- ◘ S,PXXX = SUMP PUMP
- ◘ * S,PXXX = PERMIT SUMP PUMP

REGISTERED PROFESSIONAL ENGINEER
No. 7288437-2202
JOHN WILLIAM ORDANELL
12/16/21
STATE OF UTAH

REFERENCE DRAWINGS

DRAWING NO	TITLE

REVISIONS

NO	DESCRIPTION	DATE	BY	CHK		ENG MGR
15	RELOCATE T611, AS BUILT BLDGS 68 & 69	10-5-2011	TJK			TJK
16	ADD REF. NORTH & SOUTH COMPARTMENTS BLDG 69	03-28-12	TJK			TJK
17	MOVE EDUCT. 68 & 69, ADD BLDG E-8, 70 & 71	10-25-20	KB	TH	SS	KB
18	MOVE BLDG 68 & 69, ADD BLDG 70 & 71	03-03-21	KB	TH	MM	KB
19	AS-BUILT (MODULAR BUILDINGS)	12-10-21	KB	TH		KB

REVISIONS

NO	DESCRIPTION	DATE	BY	CHK		ENG MGR
11	PERMIT SUMPS & SUMP PUMPS' LOCATION	07-10-95	DCP			
11	REMOVAL OF SUMP TRENCHES	2-17-00	GVC			
12	ADDED CYLINDER STORAGE, OTHER CHANGES	6-9-03	KL			
13	ADDED SUMP	02-22-08	KL			
14	ADDED T611, BLDG 68 & 69 WITH SUMPS	40CT10	BAD	WC		BAD

APPROVALS

	BY	DATE
DRAWN	cm	12-18-98
CHECKED		
ELEC		
MECH		
STRUCT		
PROJECT ENG		
ENGINEERING MGR		
AS BUILT		

REGISTERED PROFESSIONAL ENGINEER
DATE: _____

CleanHarbors
ARAGONITE LLC

THIS DRAWING IS THE PROPERTY OF CLEAN HARBORS ARAGONITE, LLC. ANY INFORMATION CONTAINED HEREON MAY NOT BE COPIED OR USED WITHOUT WRITTEN PERMISSION OF OWNER.

TITLE
UTAH ENVIRONMENTAL SERVICE CENTER
INCINERATION PLANT FOR INDUSTRIAL WASTES
SUMP AND SUMP PUMP LOCATION

FOR	CAD NO.
TOOELE SITE	MA065H

SCALE	JOB NO	APTUS DWG NO	REV
1"= 60'-0"		D-034-M-002-SP	22