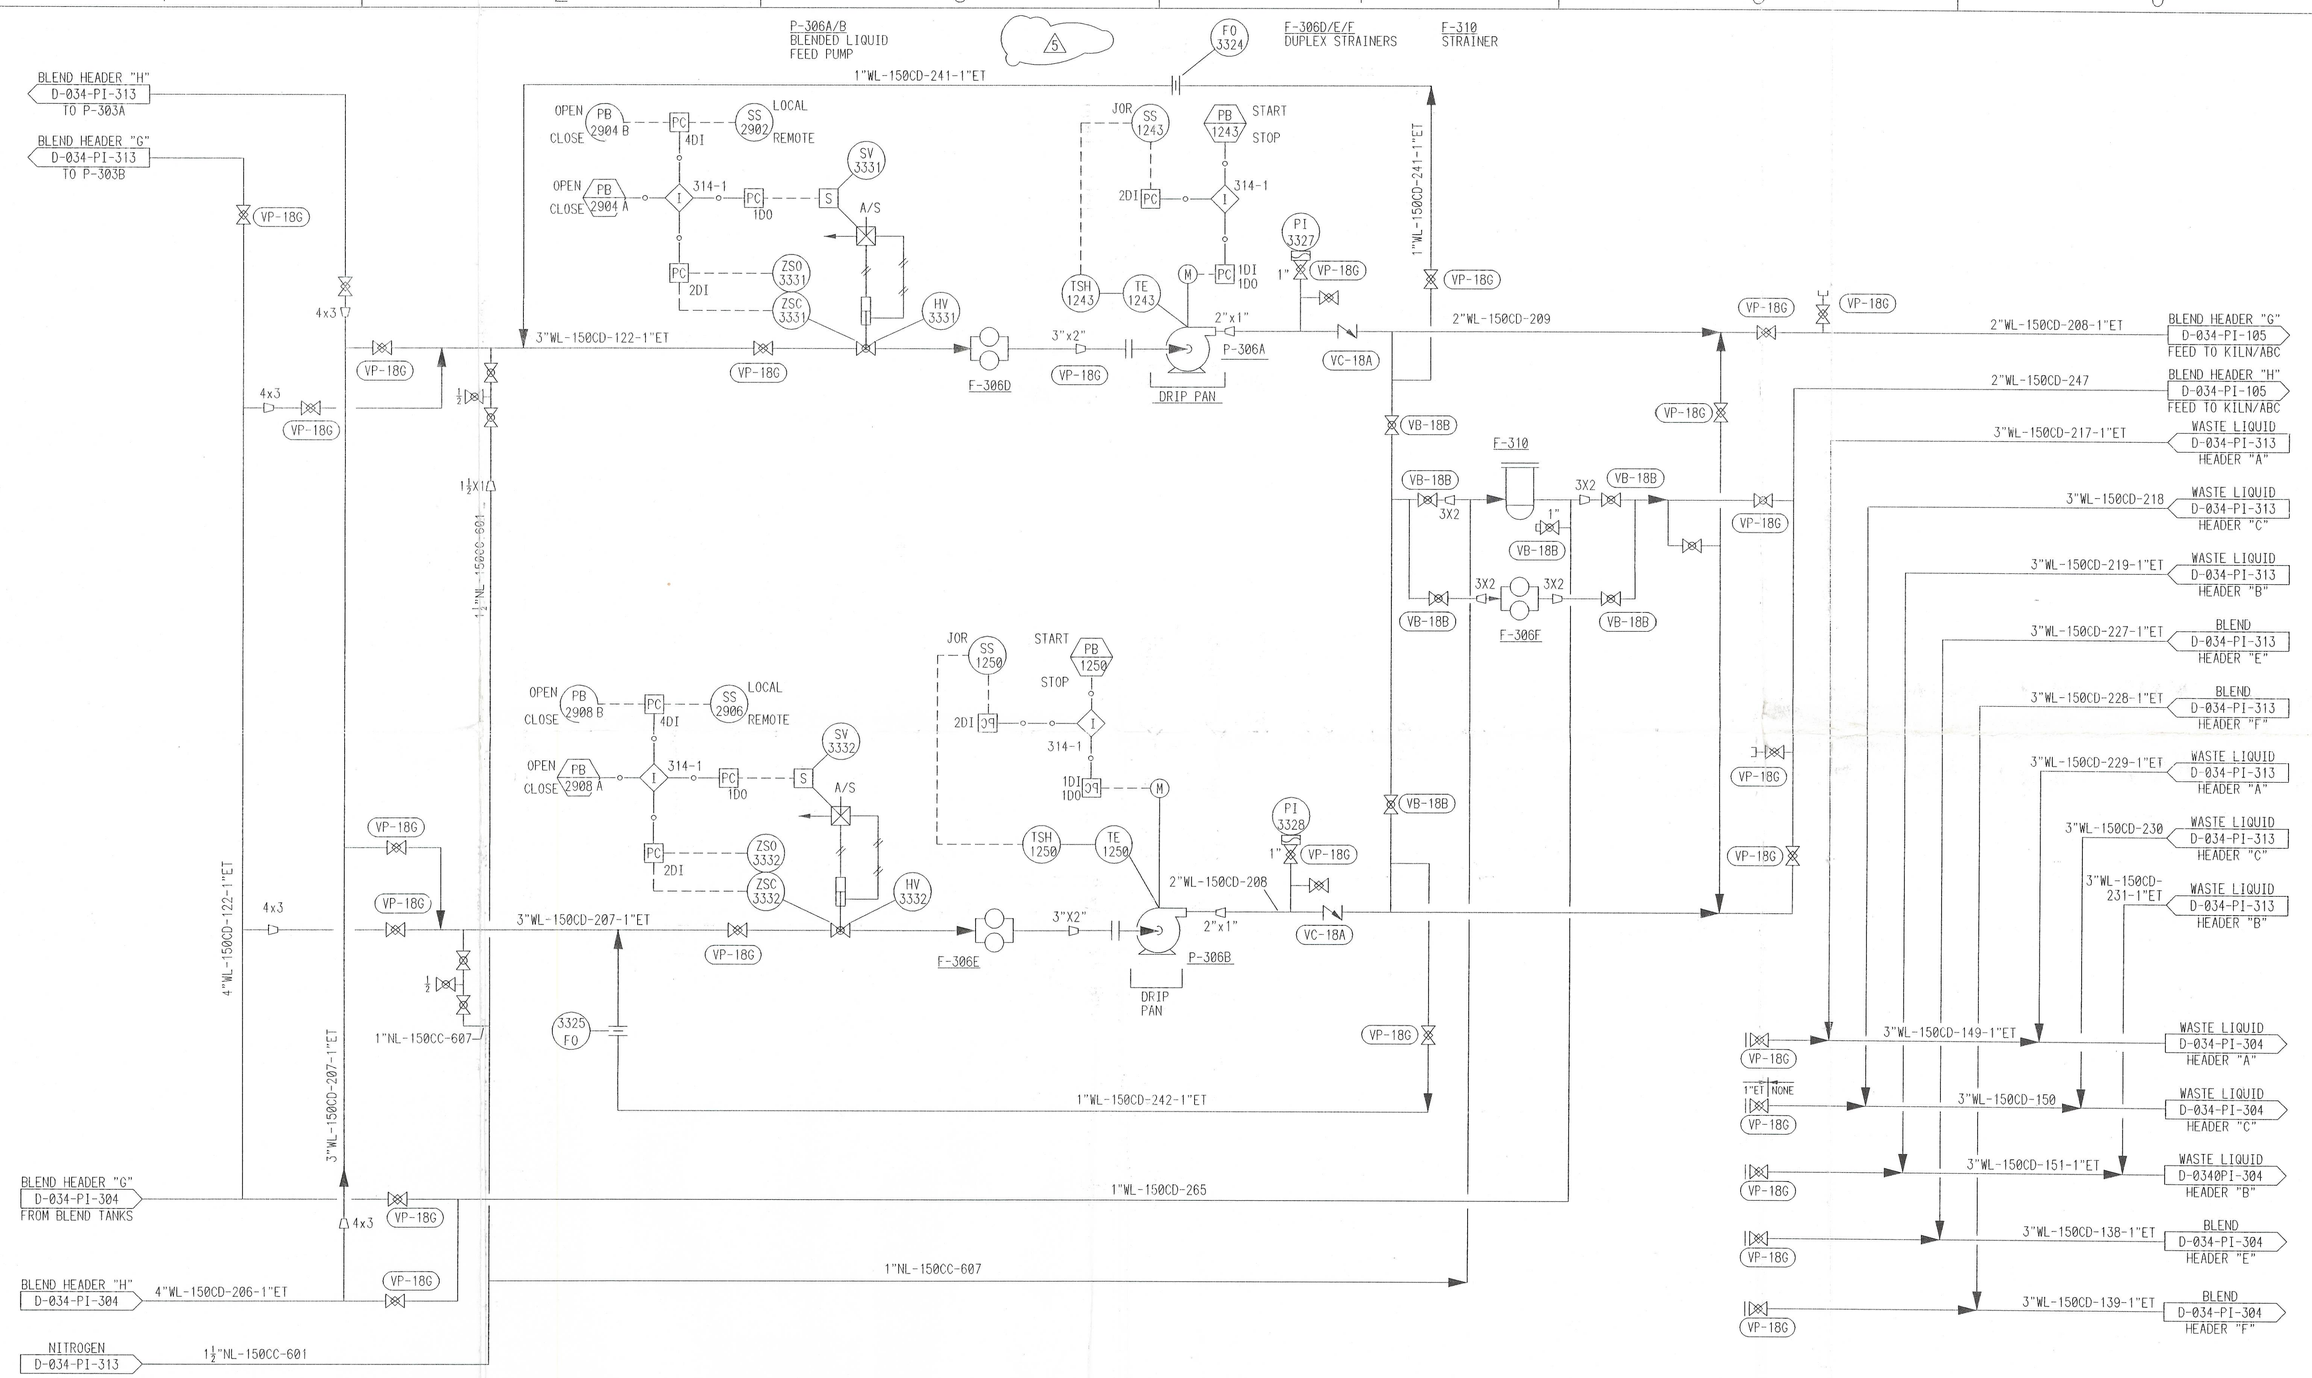

INTERLOCK DESCRIPTION

314-1 VALVE MUST BE OPEN BEFORE PUMP START

REVISIONS

NO	DESCRIPTION	DATE	BY	CHK		ENG MGR
0	ISSUED FOR CONSTRUCTION	07-07-89	MU	IRB		JV
1	AS BUILT UPDATE	01-05-94	DCP	GVC		
2	NEW NITROGEN LINES	03-01-94	DCP			
3	REMOVED P-308 PUMP & ADDED STRAINERS	06-25-96	DCP			
4	AS BUILT	03-27-97	GVC			

REVISIONS

NO	DESCRIPTION	DATE	BY	CHK		ENG MGR
5	TO CORRECT DRAFTING ERRORS	04-08-98	CRM			

APPROVALS

	BY	DATE
DRAWN	GVC	03-27-97
CHECKED		
ELEC		
MECH		
STRUCT		
PROJECT ENG		
ENGINEERING MGR		
AS BUILT		

LICENSED PROFESSIONAL ENGINEER No. 158595 JUAN G. VILLARREAL, JR. STATE OF UTAH

REGISTERED PROFESSIONAL ENGINEER
DATE: 9-16-98

LAIDLAW
ENVIRONMENTAL SERVICES (ARAGONITE), INC.
11600 NORTH APTUS ROAD, ARAGONITE, UT. 84029

TITLE
UTAH ENVIRONMENTAL SERVICE CENTER
P&ID BLENDED LIQUID FEED
AND TRANSFER PUMPS

FOR TOOELE SITE
CAD NO. 117060
SCALE
JOB NO
APTUS DWG NO D-034-PI-314
REV 5