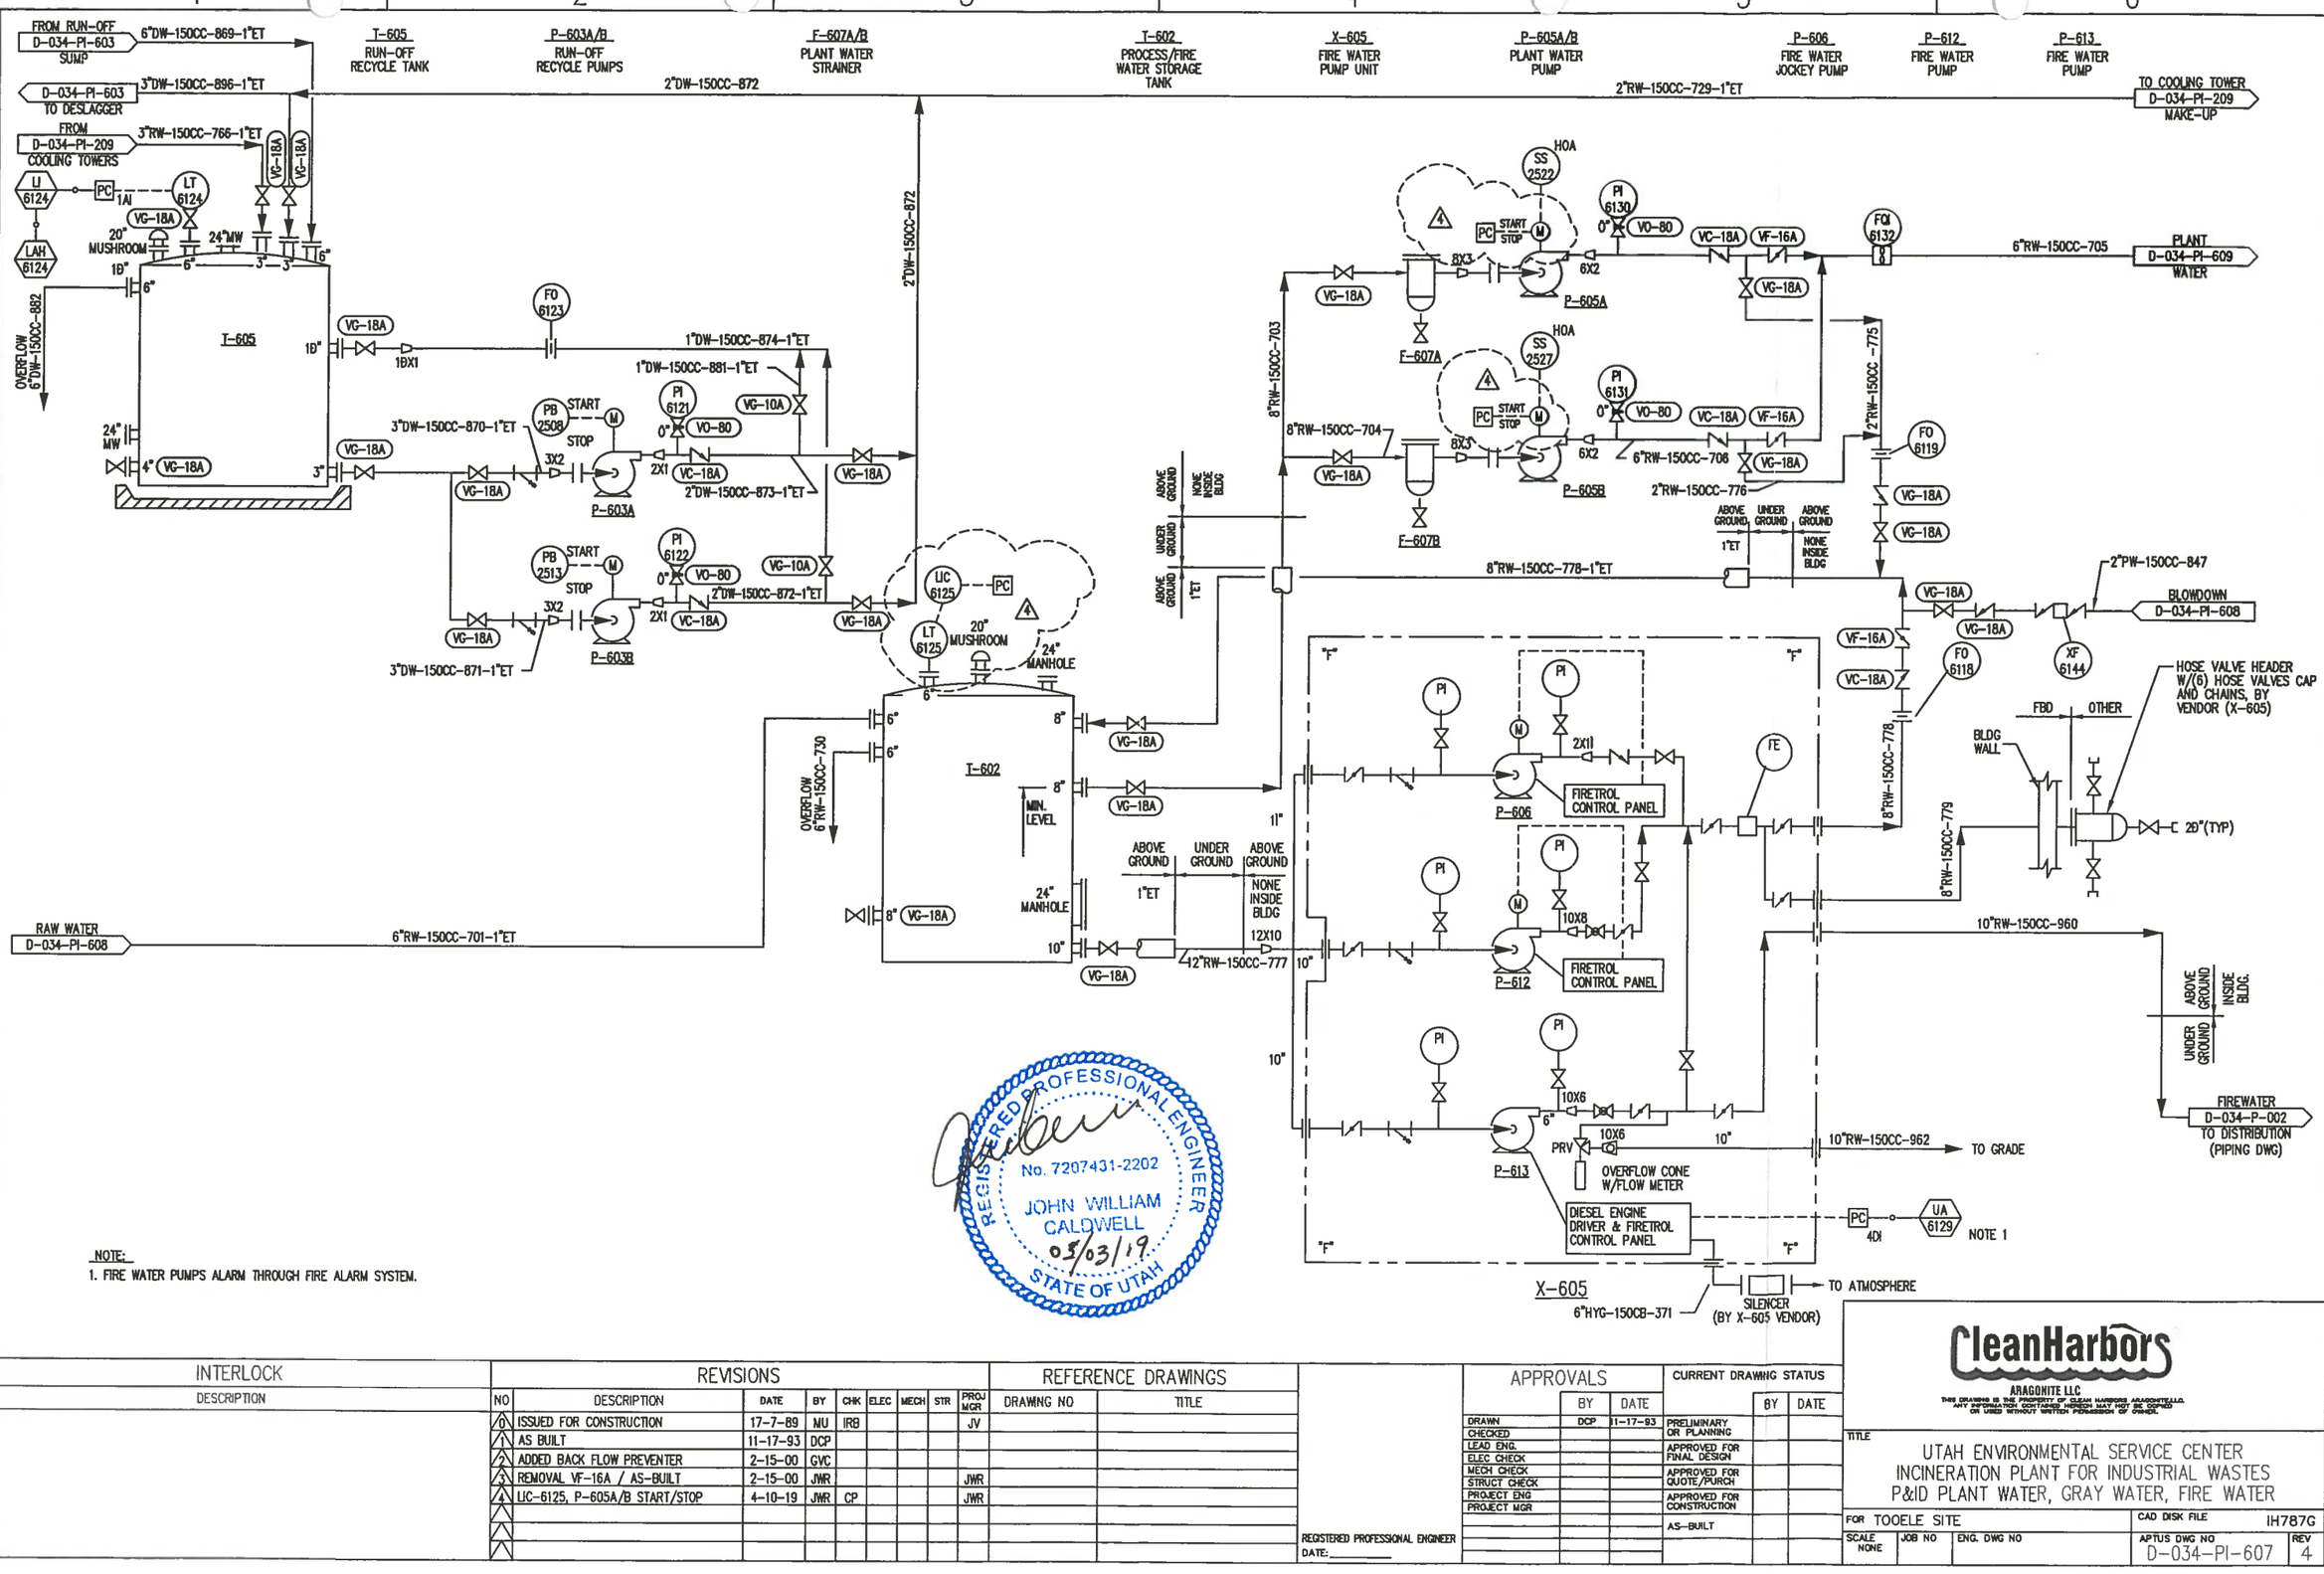

NOTE:
1. FIRE WATER PUMPS ALARM THROUGH FIRE ALARM SYSTEM.

REGISTERED PROFESSIONAL ENGINEER
No. 7207431-2202
JOHN WILLIAM CALDWELL
05/03/19
STATE OF UTAH

INTERLOCK
DESCRIPTION

REVISIONS

NO	DESCRIPTION	DATE	BY	CHK	ELEC	MECH	STR	PROJ MGR
0	ISSUED FOR CONSTRUCTION	17-7-89	MU	IRB				JV
1	AS BUILT	11-17-93	DCP					
2	ADDED BACK FLOW PREVENTER	2-15-00	GVC					
3	REMOVAL VF-16A / AS-BUILT	2-15-00	JWR					JWR
4	LIC-6125, P-605A/B START/STOP	4-10-19	JWR	CP				JWR

REFERENCE DRAWINGS

DRAWING NO	TITLE

REGISTERED PROFESSIONAL ENGINEER
DATE:

APPROVALS

	BY	DATE
DRAWN	DCP	11-17-93
CHECKED		
LEAD ENG.		
ELEC CHECK		
MECH CHECK		
STRUCT CHECK		
PROJECT ENG		
PROJECT MGR		

CURRENT DRAWING STATUS

	BY	DATE
PRELIMINARY OR PLANNING		
APPROVED FOR FINAL DESIGN		
APPROVED FOR QUOTE/PURCH		
APPROVED FOR CONSTRUCTION		
AS-BUILT		

CleanHarbors
ARAGONITE LLC
THIS DRAWING IS THE PROPERTY OF CLEAN HARBORS ARAGONITE LLC. ANY INFORMATION CONTAINED HEREON MAY NOT BE COPIED OR USED WITHOUT WRITTEN PERMISSION OF OWNER.

TITLE
UTAH ENVIRONMENTAL SERVICE CENTER
INCINERATION PLANT FOR INDUSTRIAL WASTES
P&ID PLANT WATER, GRAY WATER, FIRE WATER

FOR TOOELE SITE
CAD DISK FILE IH787G
SCALE NONE | JOB NO | ENG. DWG NO | APTUS DWG NO D-034-PI-607 | REV 4