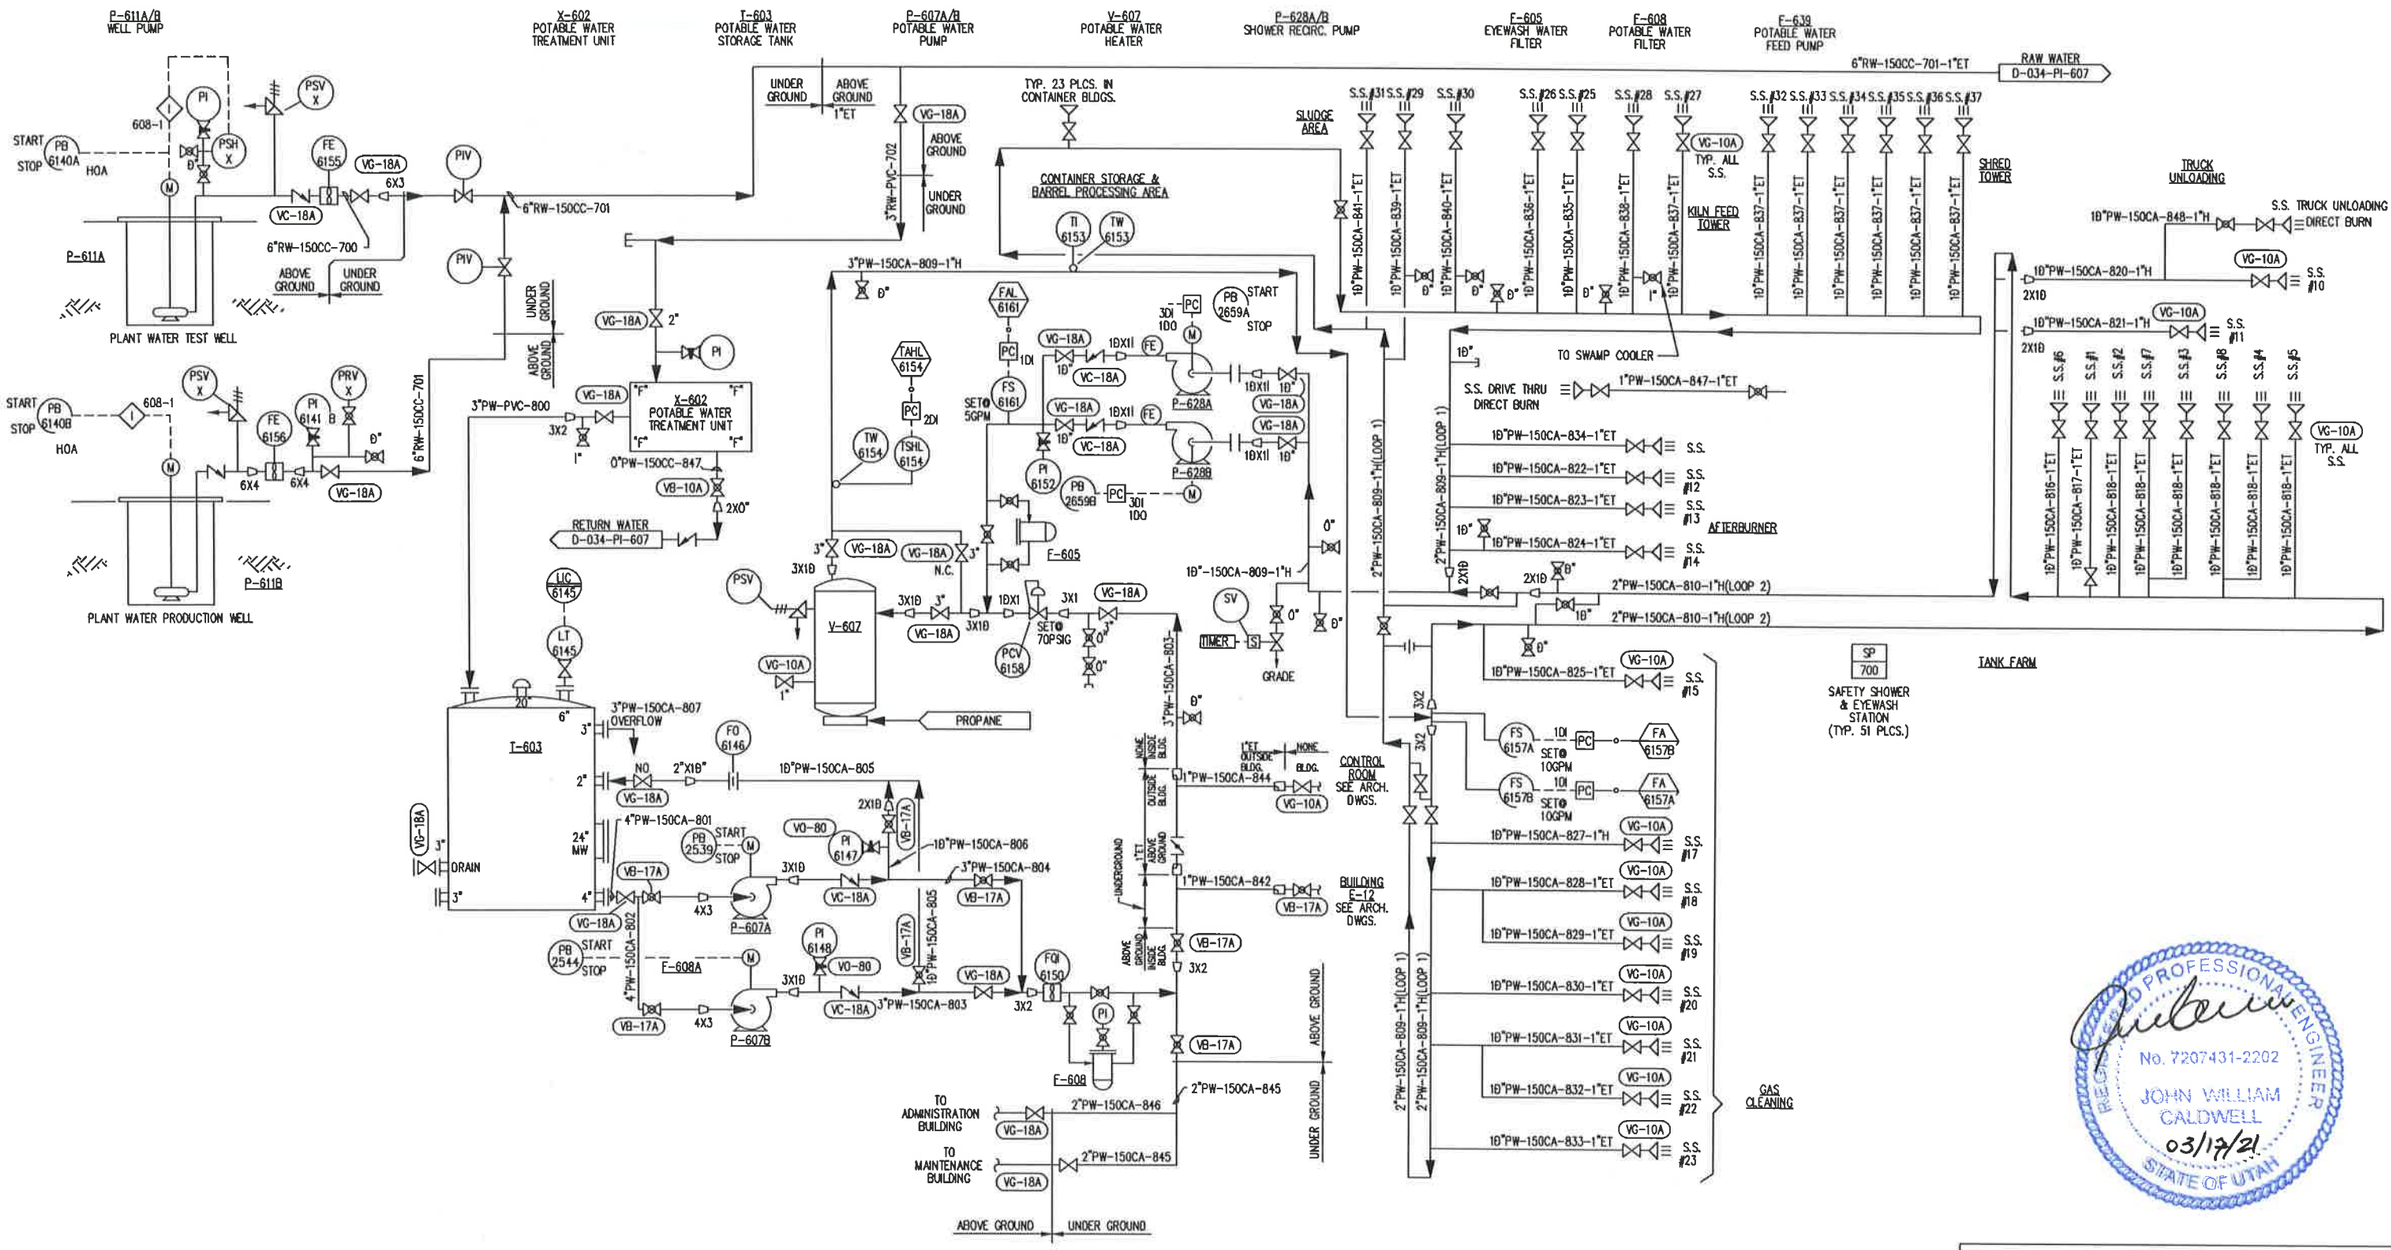

NOTES:

REVISIONS

NO	DESCRIPTION	DATE	BY	CHK		ENG MGR
0	ISSUED FOR CONSTRUCTION	7/7/98	MJ	WB		JV
1	CORRECT DRAFTING ERRORS	4/8/99	CRM			
4	ADDED SS TO DIRECT BURN TANKER AREA	3/8/01	CVC			
6	CHANGED TO CLEAN HARBORS TITLE BLOCK	12/8/17	CBS			
8	ADDED SHRED TOWER INFO	03/07/19	PGC			

REVISIONS

NO	DESCRIPTION	DATE	BY	CHK		ENG MGR
1	AS BUILT UPDATE	1/3/94	DCP			
2	AS BUILT	10/8/00	CVC			
5	ADDED SS TO TRUCK UNLOADING DIRECT BURN	3/19/03	KL			
7	ADDED 3 PW TO 6" RW-150CC-701	10/17/18	JWR			JWR
10	AS-BUILT	03-16-21	KB	TH		KB

APPROVALS

	BY	DATE
DRAWN	CRM	4/9/98
CHECKED		
ELEC		
MECH		
STRUCT		
PROJECT ENG		
ENGINEERING MGR		
AS BUILT		

REGISTERED PROFESSIONAL ENGINEER
DATE:_____

CleanHarbors
ARAGONITE LLC
THIS DRAWING IS THE PROPERTY OF CLEAN HARBORS ARAGONITE LLC ANY INFORMATION CONTAINED HEREIN MAY NOT BE COPIED OR USED WITHOUT WRITTEN PERMISSION OF OWNER.

UTAH ENVIRONMENTAL SERVICE CENTER
INDUSTRIAL WASTE INCINERATION PLANT
POTABLE WATER P&ID

FOR		CAD NO.	
SCALE	JOB NO	APTUS DWG NO	REV
		D-034-PI-608	10