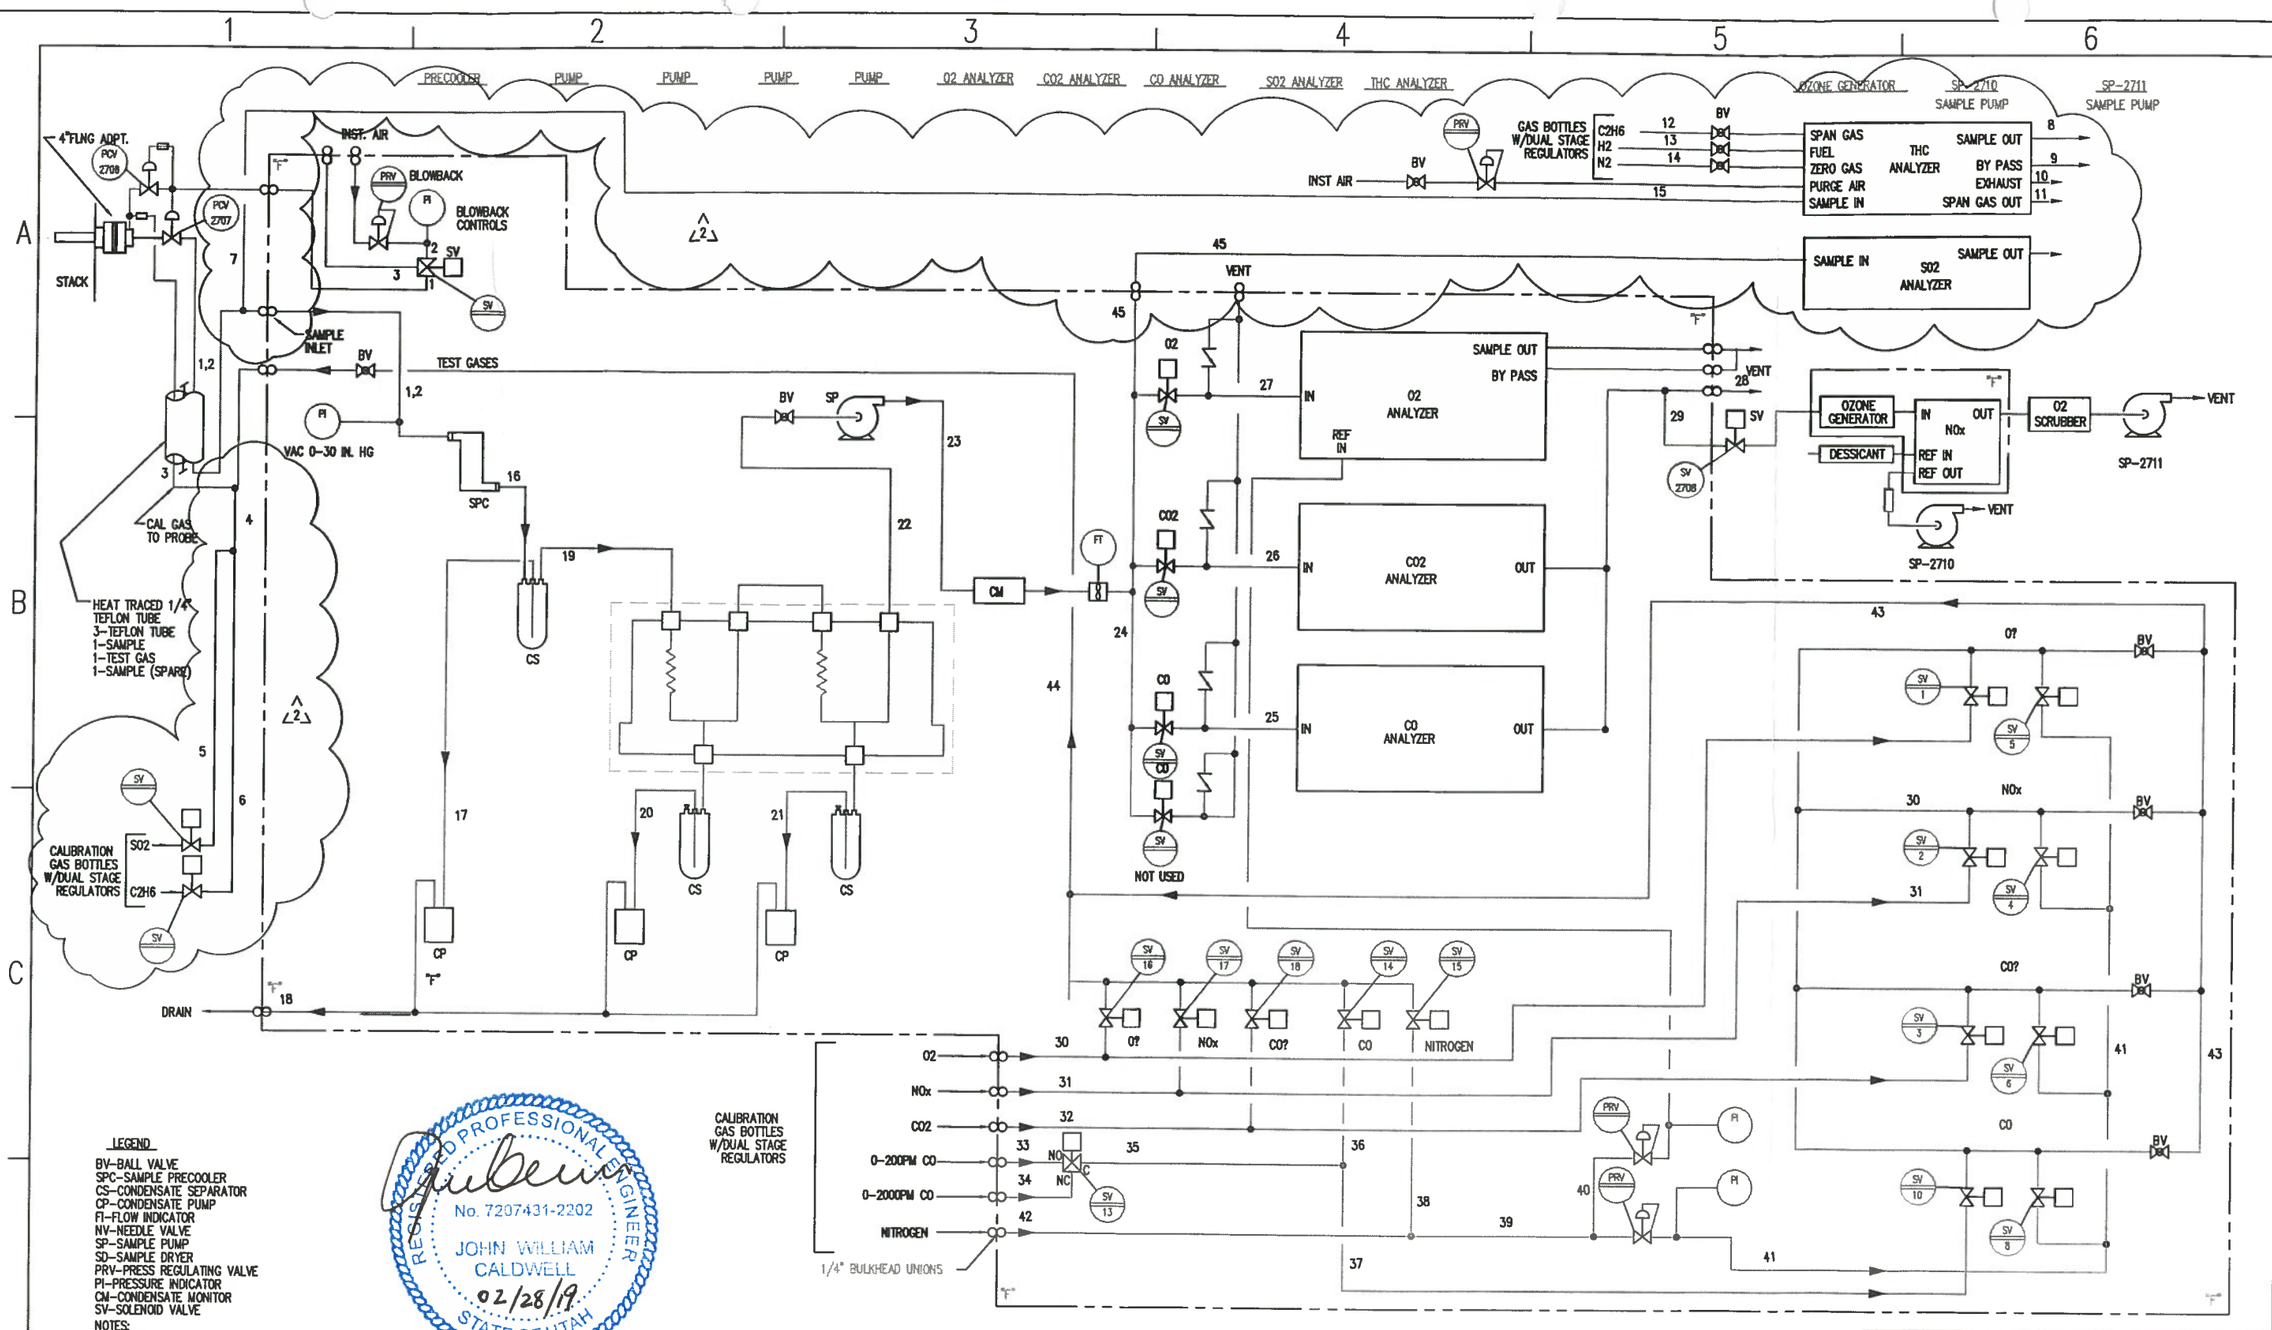

LEGEND

BV–BALL VALVE
SPC–SAMPLE PRECOOLER
CS–CONDENSATE SEPARATOR
CP–CONDENSATE PUMP
FI–FLOW INDICATOR
NV–NEEDLE VALVE
SP–SAMPLE PUMP
SD–SAMPLE DRYER
PRV–PRESS REGULATING VALVE
PI–PRESSURE INDICATOR
CM–CONDENSATE MONITOR
SV–SOLENOID VALVE

NOTES:

1. THIS DRAWING WAS ORIGINALLY CREATED BY ROSEMOUNT ANALYTICAL INC. AND REVISED BY APTUS INC.

REGISTERED PROFESSIONAL ENGINEER
No. 7207431-2202
JOHN WILLIAM CALDWELL
02/28/19
STATE OF UTAH

REFERENCE DRAWINGS

DRAWING NO	TITLE

REVISIONS

NO	DESCRIPTION	DATE	BY	CHK	ENG MGR
0	AS BUILT	4-27-00	KGB		
1	CHANGE CAD NO. FROM AP464B TO AP462A	09-16-02	KL		
2	ADDED SO2 AND THC ANALYZERS	10-23-03	LCC		

REVISIONS

NO	DESCRIPTION	DATE	BY	CHK	ENG MGR

APPROVALS

	BY	DATE
DRAWN	KGB	4-25-00
CHECKED		
ELEC		
MECH		
STRUCT		
PROJECT ENG		
ENGINEERING MGR		
AS BUILT		

REGISTERED PROF. MECHANICAL ENGINEER
DATE

CleanHarbors
ARAGONITE LLC

TITLE: UTAH ENVIRONMENTAL SERVICE CENTER
PIPING DIAGRAM
CEM #2 SYSTEM

FOR: TOOELE SITE
CAD NO: AP462B
SCALE: NA
ROSEMOUNT DWG. NO: 3038359
APTUS DWG NO: D-800-PI-216
REV: 2