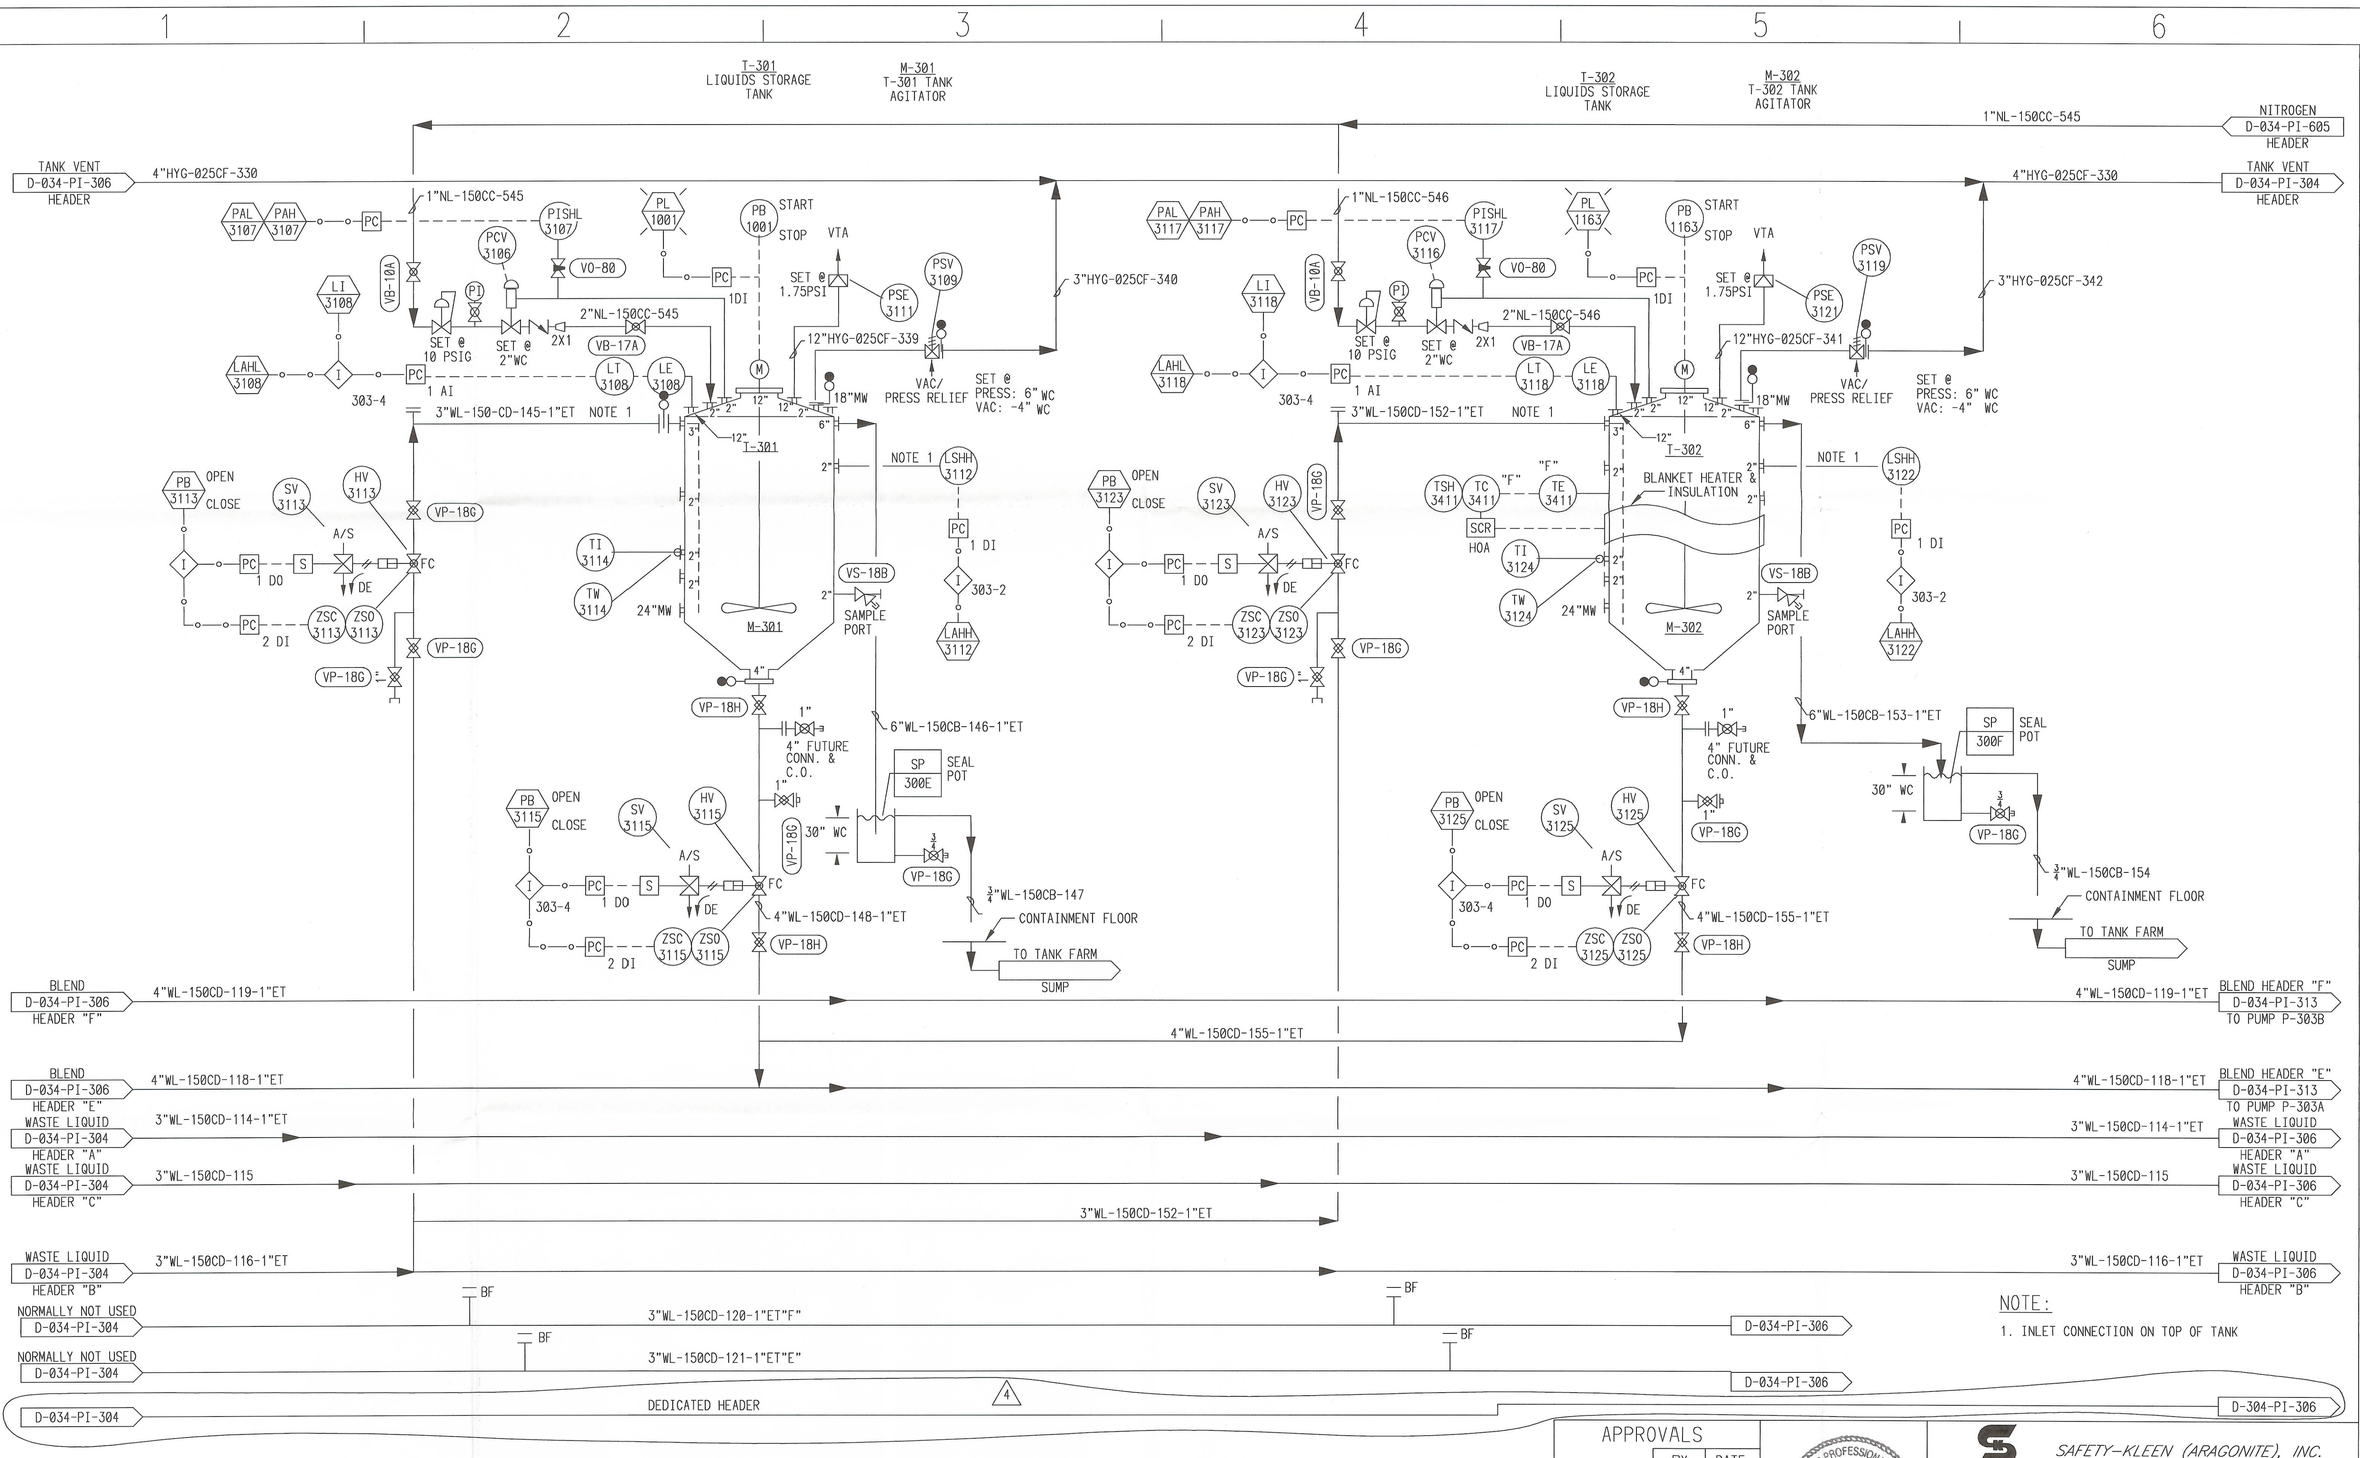

NOTE:

1. INLET CONNECTION ON TOP OF TANK

INTERLOCK DESCRIPTION

303-2 SHUTDOWN PUMP AND CLOSE INLET VALVE

303-4 LOW LEVEL CLOSES OUTLET VALVE UNLESS MANUAL OVERRIDE AND SHUTDOWN PUMP.

REVISIONS

NO	DESCRIPTION	DATE	BY	CHK		ENG MGR
0	ISSUED FOR CONSTRUCTION	07-07-89	MU	IRB		JV
1	AS BUILT UPDATE	12-30-93	DCP			
2	ADDED TSH & PRESSURE ALARMS	11-09-98	CRM			
3	AS BUILT	9-27-00	GVC			
4	ADD DEDICATED HEADER	04-26-02	KL			

REVISIONS

NO	DESCRIPTION	DATE	BY	CHK		ENG MGR
4	ADDED DEDICATED SERVICE	05-07-02	KL			

APPROVALS

	BY	DATE
DRAWN	CRM	11-09-98
CHECKED		
ELEC		
MECH		
STRUCT		
PROJECT ENG		
ENGINEERING MGR		
AS BUILT		

REGISTERED PROFESSIONAL ENGINEER
No. 189797
LAYNE D. JENSEN
STATE OF UTAH

REGISTERED PROFESSIONAL ENGINEER
DATE: 5-7-02

safety-kleen

SAFETY-KLEEN (ARAGONITE), INC.
11600 NORTH APTUS ROAD, ARAGONITE, UT. 84029

TITLE
UTAH ENVIRONMENTAL SERVICE CENTER
INCINERATION PLANT FOR INDUSTRIAL WASTES
P&ID LIQUIDS STORAGE

FOR TOOELE SITE
CAD NO. IH785S
SCALE
JOB NO
SAFETY-KLEEN DWG NO D-034-PI-305
REV 4