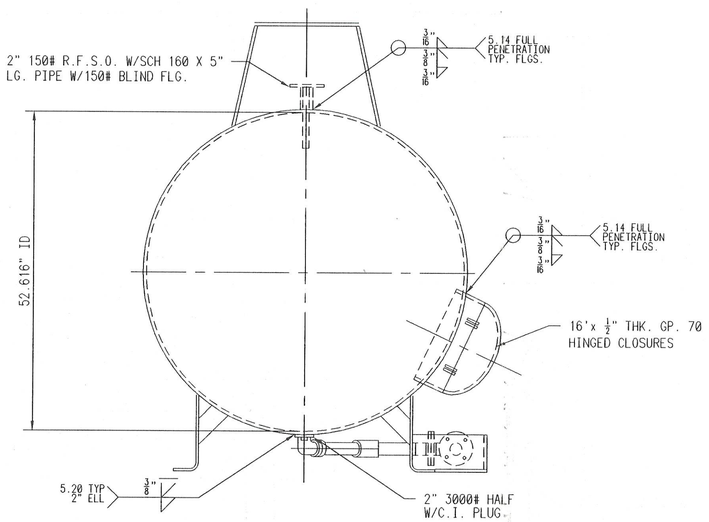

END VIEW

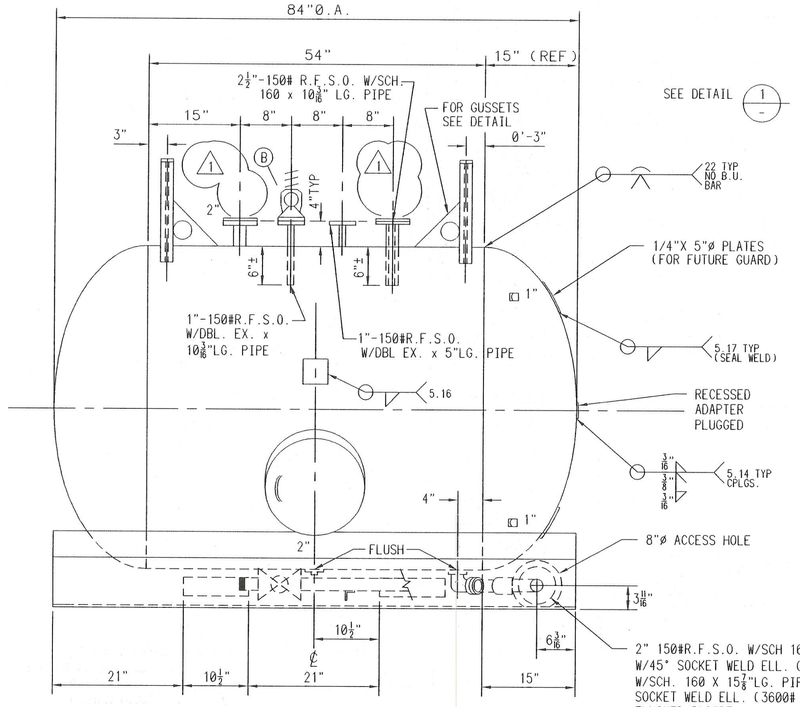

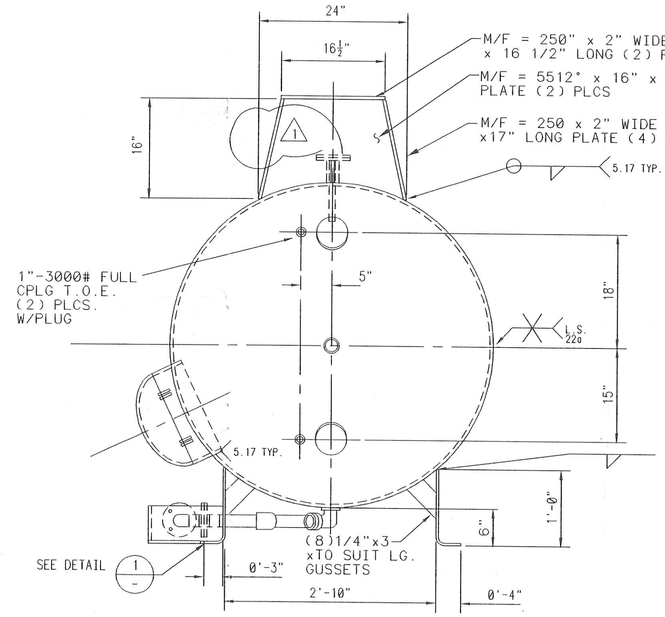

END VIEW

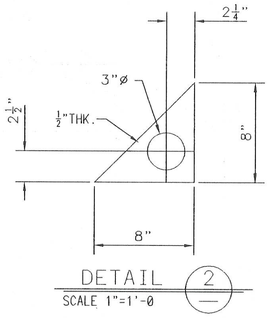

DETAIL 2
SCALE 1"=1'-0

GUSSET DETAIL
(2) REQ'D

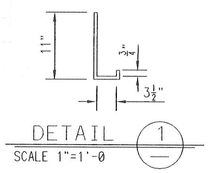

DETAIL 1
SCALE 1"=1'-0

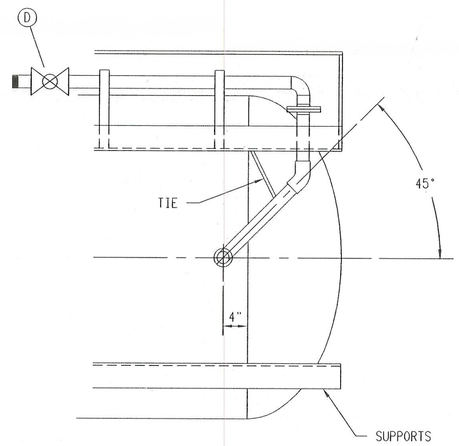

BIM. VIEW OF 2" PIPING

VALVE SCHEDULE		
ITEM	QTY.	DESCRIPTION
B	1	1" C.S. PSV SET @ 120 PSIG
D	1	2" 150# C.S. BALL VALVE

1

NOTES:

1. TANK TO BE IN ACCORDANCE WITH ASME CODE SECTION VIII. DIVISION 1 AND FORD, BACON, AND DAVIS SPEC. SP-800-M-014
2. ALL FLANGES TO BE R.F.
3. DESIGN PRESSURE 125 PSI
   HYDROSTATIC TEST PRESSURE 190 PSI
   DESIGN TEMPERATURE 200°F
   CORROSION ALLOWANCE 1/8"
   DESIGN EXTERNAL PRESSURE 15 PSI
4. HEAD & SHELL .375" SA-455

REFERENCE DRAWINGS	
DRAWING NO	TITLE

REVISIONS							
NO	DESCRIPTION	DATE	BY	CHK		ENG MGR	NO
B	PARTIAL REDESIGN	06-01-89	RWH				B
0	AS BUILT	06-28-91	DCP	TP			0
1	REMOVED VALVE REF. & CHANGED PSV TO 120 PSIG	06-03-99	CRM			CVS	1

REVISIONS						
NO	DESCRIPTION	DATE	BY	CHK		ENG MGR

APPROVALS	BY	DATE
DRAWN	RWH	11-11-88
CHECKED		
ELEC		
MECH		
STRUCT		
PROJECT ENG		
ENGINEERING MGR		
AS BUILT		

REGISTERED PROFESSIONAL ENGINEER
No. 162330
THOMAS T. FUJIKAWA
STATE OF UTAH

REGISTERED PROFESSIONAL ENGINEER
DATE: 3-30-00

safety-kleen

SAFETY-KLEEN (ARAGONITE), INC.
11600 NORTH APTUS ROAD, ARAGONITE, UT. 84029

TITLE
UTAH ENVIRONMENTAL SERVICE CENTER
INCINERATION PLANT FOR INDUSTRIAL WASTES
DIRECT BURN VESSEL

FOR	TOOELE SITE	CAD NO.	MA046C	
SCALE	JOB NO	SAFETY-KLEEN DWG NO		REV
1"=1'-0"		D-800-M-122		1